

Name Eben Johnson

Service No. 27 128

Address 26 Prescott St., Arlington

8 Stevens Rd

Location 8 Gary St., Stevens Rd

Kind of Pipe

Size 6"

Size of Main 8"

Repair—Renewal—New Service

Location

| Date 1941 | Material | Amount | Total | Date | Amount |
|--------------|-------------------------|--------|-------|-------------------|--|
| Nov. 8 | 17 hrs. @ 50¢ | 8 50 | | November 11, 1941 | 60.00 |
| Com 17/24/41 | 30 " @ 60¢ | 1 8 00 | | Dec 30 1941 | 4.34 |
| | 15 " @ 65¢ | 9 75 | 36 25 | | ✓ 566 |
| | 10% Overhead | | 3 62 | | |
| | 62' 6" Sewer Pipe @ 16¢ | | 9 92 | | |
| | 1 1/8 6" Bend | | 65 | | |
| | joint compound | | 3 72 | | |
| | 2 hrs. trucking @ 75¢ | | 1 50 | | |
| | | | 55 66 | | |
| | Labor | | | 7-3-46 | Solids in M.H. @ intersection Sutherland Rd |

Hidley Pres. Inc., Lexington

TOWN OF LEXINGTON—BOARD OF PUBLIC WORKS

SEWER DIVISION

DATE Nov 3 1941


NO. _____

The undersigned applies for the construction of a particular sewer connecting No. 8 Cary St Street and hereby agrees to comply with the Rules and Regulations governing the construction and use of Particular Sewers, as now or at any future time established by the Board of Selectmen.

Am't. of Estimate \$ 65

Am't. Paid \$ _____

Eben Johnson Owner

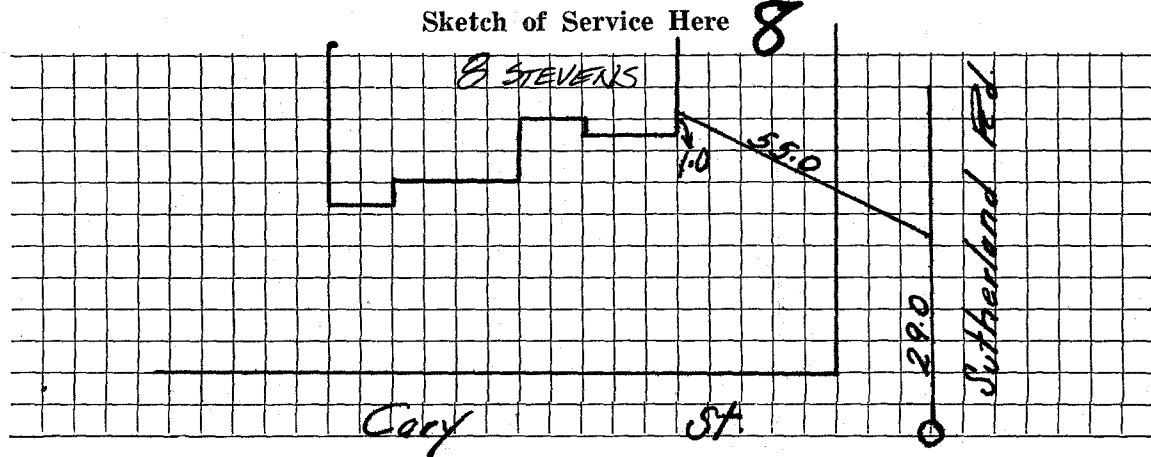

Connection made in _____ Street.

Work completed _____ 19

Remarks: