

Name Anthony Tucci

Service No. 16 1030 (46)

Address 9 Cary Street - 9 Stevens Rd

Lexington, Mass.

Location 9 Cary Street

Kind of Pipe

Size 6"

Size of Main 8"

~~Repair~~ ~~Renewal~~ New Service Com. 12-9-46

Location

Date	Material	Amount	Total	Date	Amount
Aug. 12, '46	Labor	31 64		Aug 7, '46	80 00
14, '46	"	32 67			
15, '46	"	<u>11 39</u>	75 70	10-16-47	
	10% Overhead		7 57	38' 6" Sewer Pipe	
	40' - 6" Sewer Pipe @.255		10 20		
	1 - 6" Elbow		2 70		
	Joint Compound		2 40	Bill sent # 1-47	
	Gas Pump 3 hrs. @1.00		3 00		
	Compressor 1 hr. @1.75		1 75		
	Trucking 1 hr. @.75		<u>75</u>		
			102 07		
	Labor				

TOWN OF LEXINGTON—DEPT. OF PUBLIC WORKS  
**SEWER DIVISION**

DATE .....


NO. ....

The undersigned applies for the construction of a particular sewer connecting No. ....  
Street and hereby agrees to comply with the Rules and Regulations governing the construction and use of Particular  
Sewers, as now or at any future time established by the Board of Selectmen.

Am't of estimate \$. ....

Am't Paid \$. ....

..... Owner

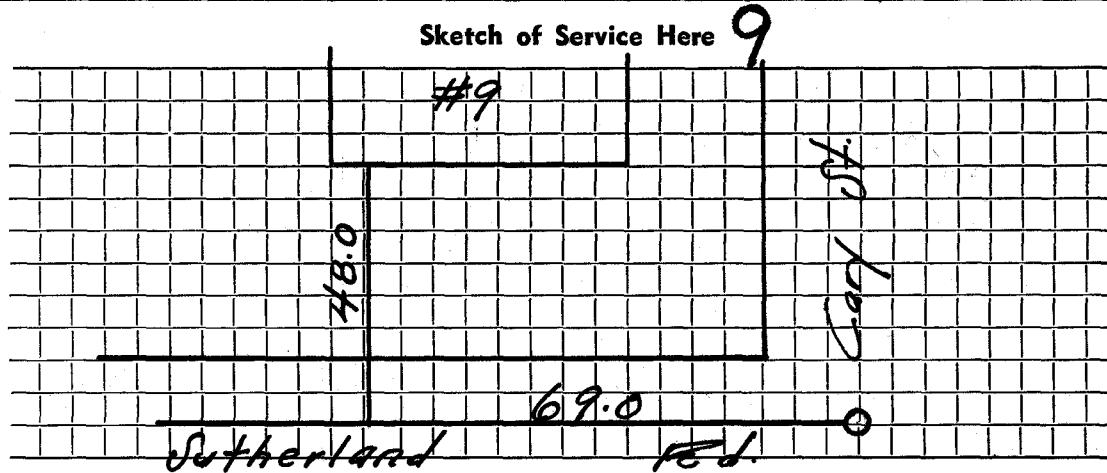

Connection made in ..... Street.

Work completed ..... 19..

Remarks: