

Name Busa Realty Trust

Service No. 17

Address ~~14 Cabot Street~~ (Changed to ~~XXXXXXXXXXXX~~ 1 Stimson Avenue)

1 Stimson Ave.

Location

Kind of Pipe

Size 6"

Size of Main 8"

~~Renewal~~ New Service W.O. #8581


Location *Com on 5-18-64*

Date	Material	Amount	Total	Date	Amount
3-26-64	Labor	37.04		3-6-64	150 00
3-27-64	"	57.56	94 60	5-18-64	38 61
	10% O.H.	9 46	104 06		188 61
28'	6" Transite Pipe @.82		22 96		
1	90° Transite Elbow		4 09		
5	Hrs. Town Shovel @6.50		32 50		
3	Hrs. Trucking @3.00		9 00		
16	X 3 Patch		16 00		
			188 61		
				12-31-64	Rate Roster Filled on weekend

DATE \_\_\_\_\_

TOWN OF LEXINGTON — BOARD OF PUBLIC WORKS  
SEWER DIVISION

Sketch of Service Here

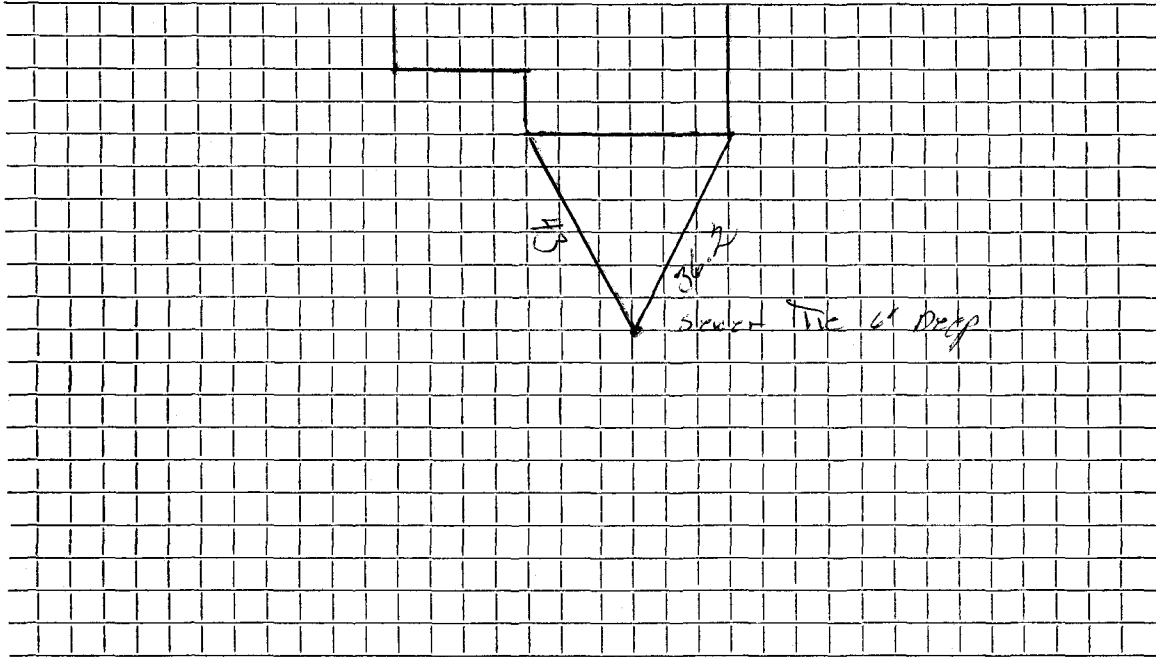

Connection made in ..... Street. Work completed .....

Remarks: .....

.....

.....