

Name Mr. Harvey Fox

Service No. 32

Address 14 Stimson Avenue

14 STIMSON AVE.

Location

Kind of Pipe

Size 6"

Size of Main 8"

~~REPAIR~~—Renewal—~~NEW SERVICE~~ W.O. #3298.Location *Comm 7-28-75*


Date	Material	Amount	Total	Date	Amount
5-5-75	Labor 47.42			5-1-75	Deposit 400.00
5-7-75	" 58.89	106.31		7-28-75	Retard 140.08
	10% O.H.	10.63	\$116.94		
40'	6" Transite Pipe @1.27		50.80		
1	30° Sweep		4.88	5-5-75	NON-CHARGE Labor \$148.19
1	0 Ring		3.05	5-7-75	" 116.69 \$264.88
10	Lbs. Grass Seed @.95		9.50	20'	6" Transite Pipe @1.17 25.40
1½	Loads Loam @36.00		54.00	1	5' x 6" Nip @1.48 7.40
2½	Hrs. Backhoe @6.50		16.25	1	1' x 6" Nip 1.76
1½	Hrs. Trucking @3.00		4.50	1	45° C.I. Saddle 24.45
			\$259.92	1	Ton 3/4" Stone 3.35
				1	Yd. Loam 6.00
				8	Lbs. Seed @.95 7.60
				3½	Ton Top 42.70
				5½	Hrs. Trucking @3.00 16.50
				2	Hrs. P.U. @1.50 3.00
				1½	Hrs. Pump @2.00 3.00
				1	Hr. Backhoe 6.50
				1½	Hrs. Loader @4.00 6.00
				1	Hr. Roller 2.00
				1	Hr. Compressor @5.00 5.00
					\$425.54
				12-14-73	Roots 10' out
				6-20-74	Slits & Broken Pipe

DATE _____

TOWN OF LEXINGTON — BOARD OF PUBLIC WORKS

SEWER DIVISION

Sketch of Service Here **14**

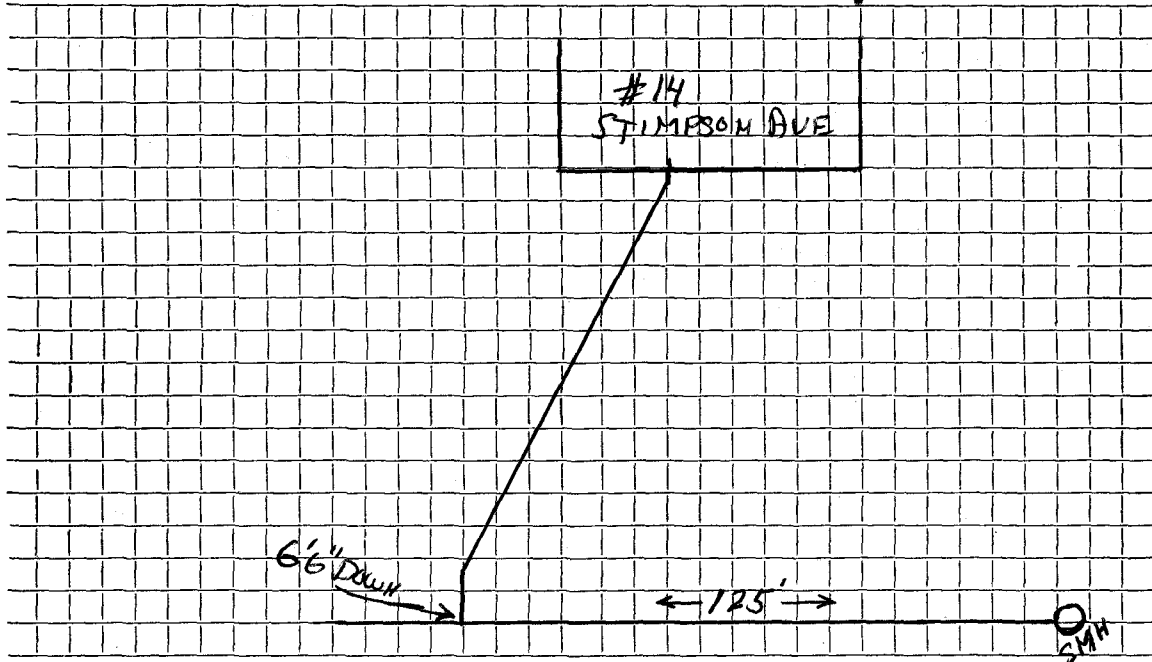

Connection made in Street. Work completed

Remarks:

.....

.....