


DATE 7/10/2017

TOWN OF LEXINGTON — BOARD OF PUBLIC WORKS
SEWER DIVISION

Sketch of Service Here

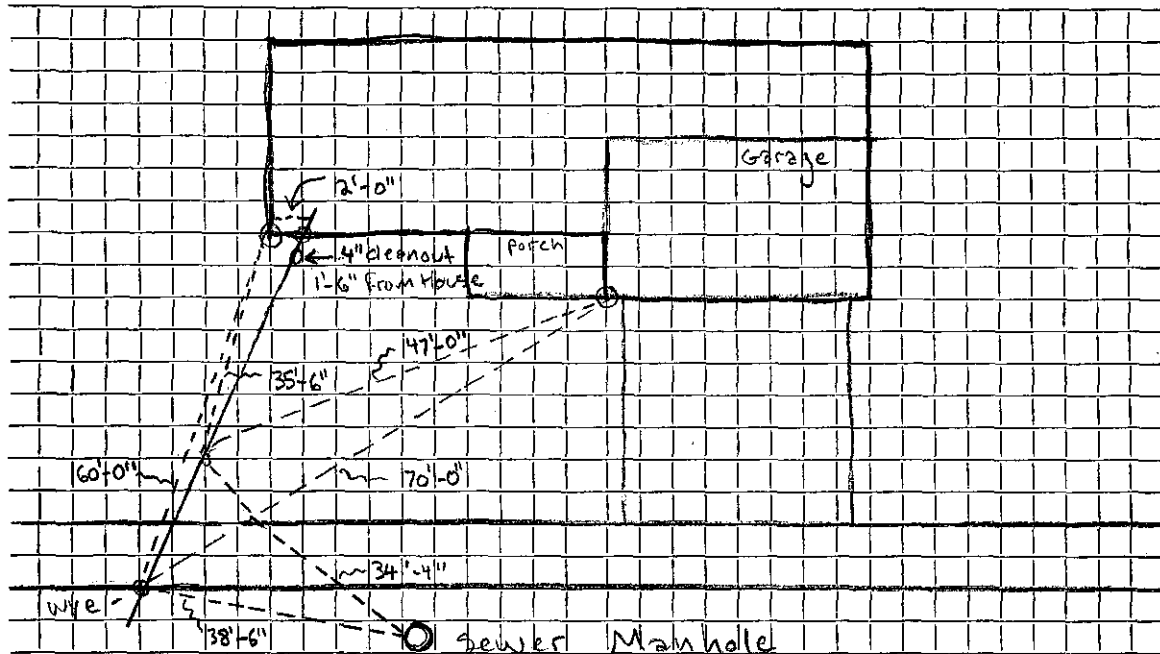

Connection made in 18 Stimson Avenue Street. Work completed

Remarks: Invert = 8'-6"

.....

.....