




DATE \_\_\_\_\_

TOWN OF LEXINGTON — BOARD OF PUBLIC WORKS

SEWER DIVISION

Sketch of Service Here

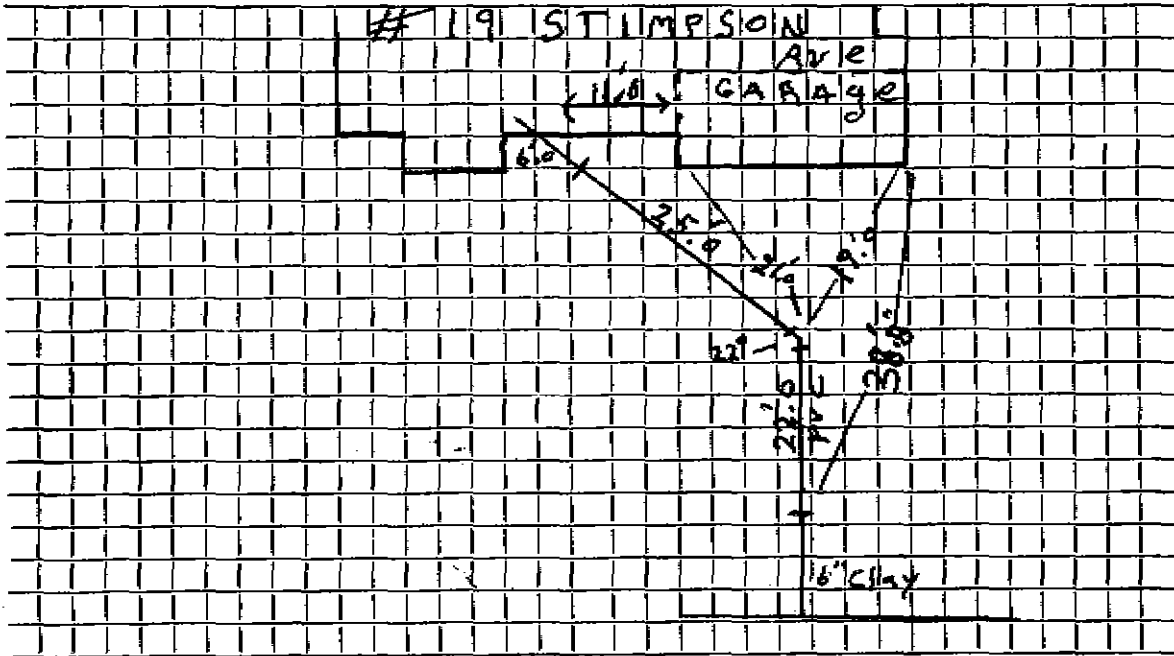

Connection made in ..... Street. - Work completed 3/17/09 J.M.L. ....

Remarks: .....  
.....  
.....