

Name

Service No. 3218

Address

27 STIMSON Ave

Location

Lot 115

Kind of Pipe PVC

Size 6"

Size of Main

Repair—Renewal—New Service

J. McLaughlin

Location

Date

Material

Amount

Total

Date


Amount

Date	Material	Amount	Total	Date	Amount
3/12/09	6' 4" sub 40				
	4.0 6" PVC				
	1 6 45° bend				
	1 4x6 Franco				
	48 6" PVC				
	1 6" PVC x Clay Franco 6.0" pipes				
	exist				
no-olcl-card	Clay Pipe				

DATE _____

TOWN OF LEXINGTON — BOARD OF PUBLIC WORKS
SEWER DIVISION

Sketch of Service Here

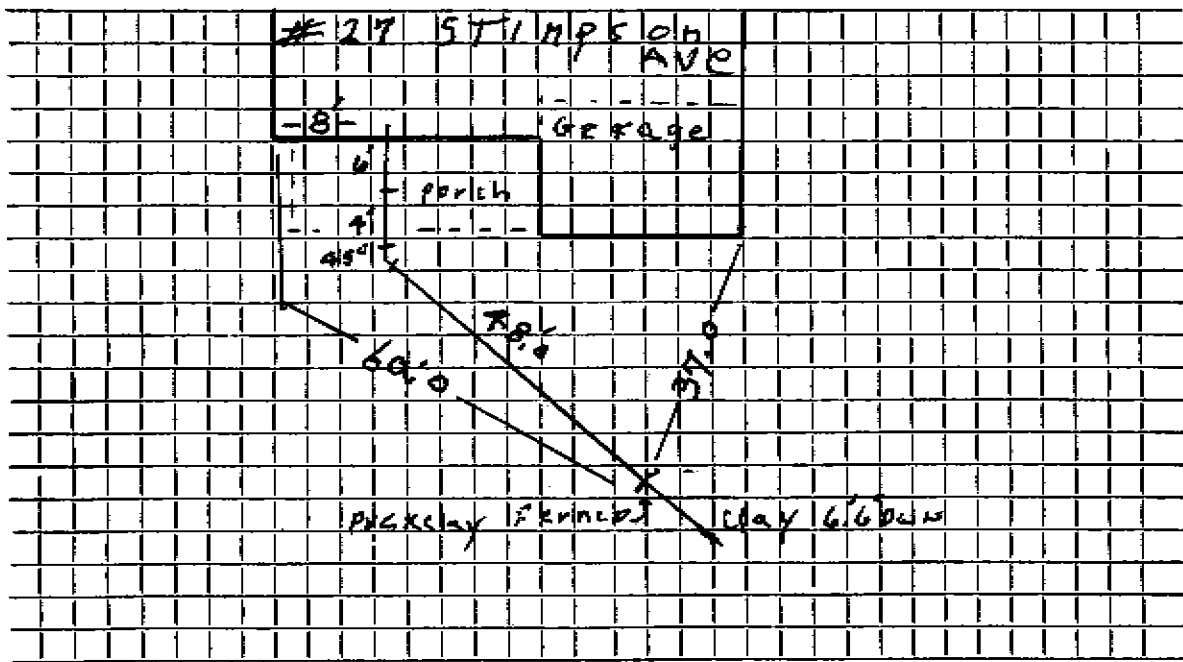

Connection made in Street. Work completed 3/12/09 J. McL.....

Remarks: No old card

.....
.....