

Name

Service No.

Address

29 Stimpson

Location

Kind of Pipe

Size

Size of Main

Repair—Renewal—New Service

Location

Date

Material

Amount

Total

Date

Amount

Inside

29' 6" PVC

2-6" 22° Bends


1-4x6 Fernco

1-6x6 PVC-clay Fernco

DATE 3-16-2004

TOWN OF LEXINGTON — BOARD OF PUBLIC WORKS
SEWER DIVISION

Sketch of Service Here

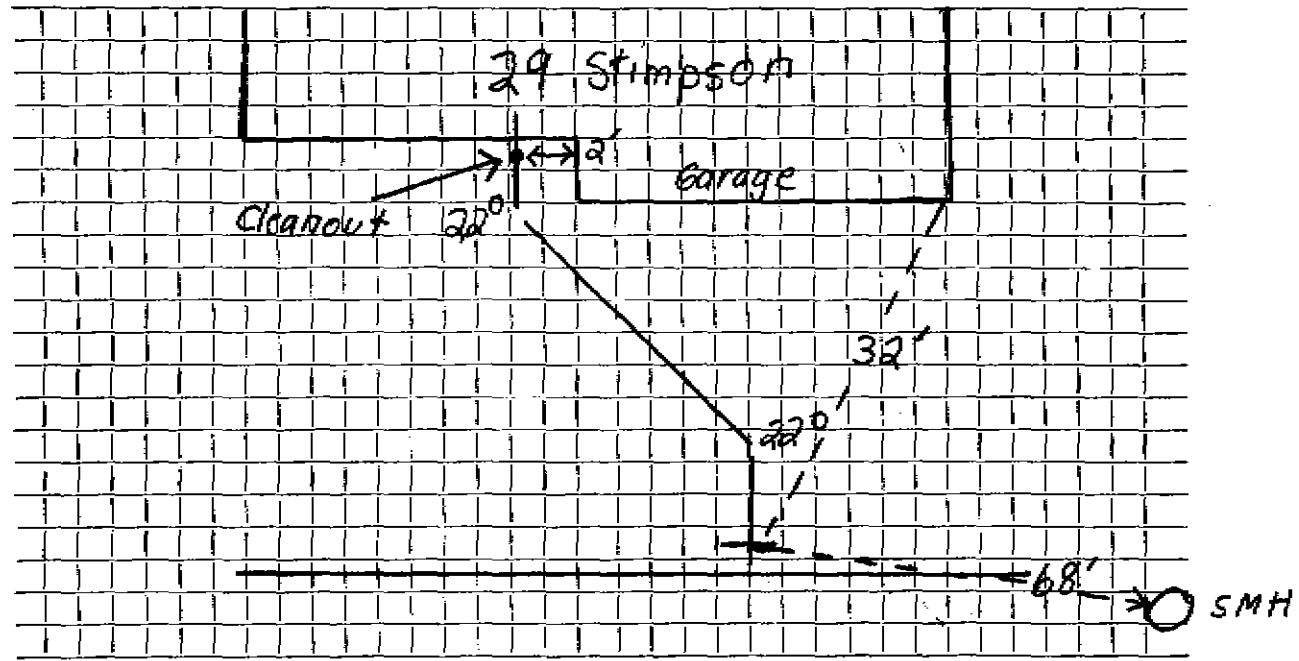

Connection made in Street. Work completed

Remarks:
.....
.....