

DATE _____


TOWN OF LEXINGTON — BOARD OF PUBLIC WORKS

SEWER DIVISION

Sketch of Service Here

3

Lot L.C. 22

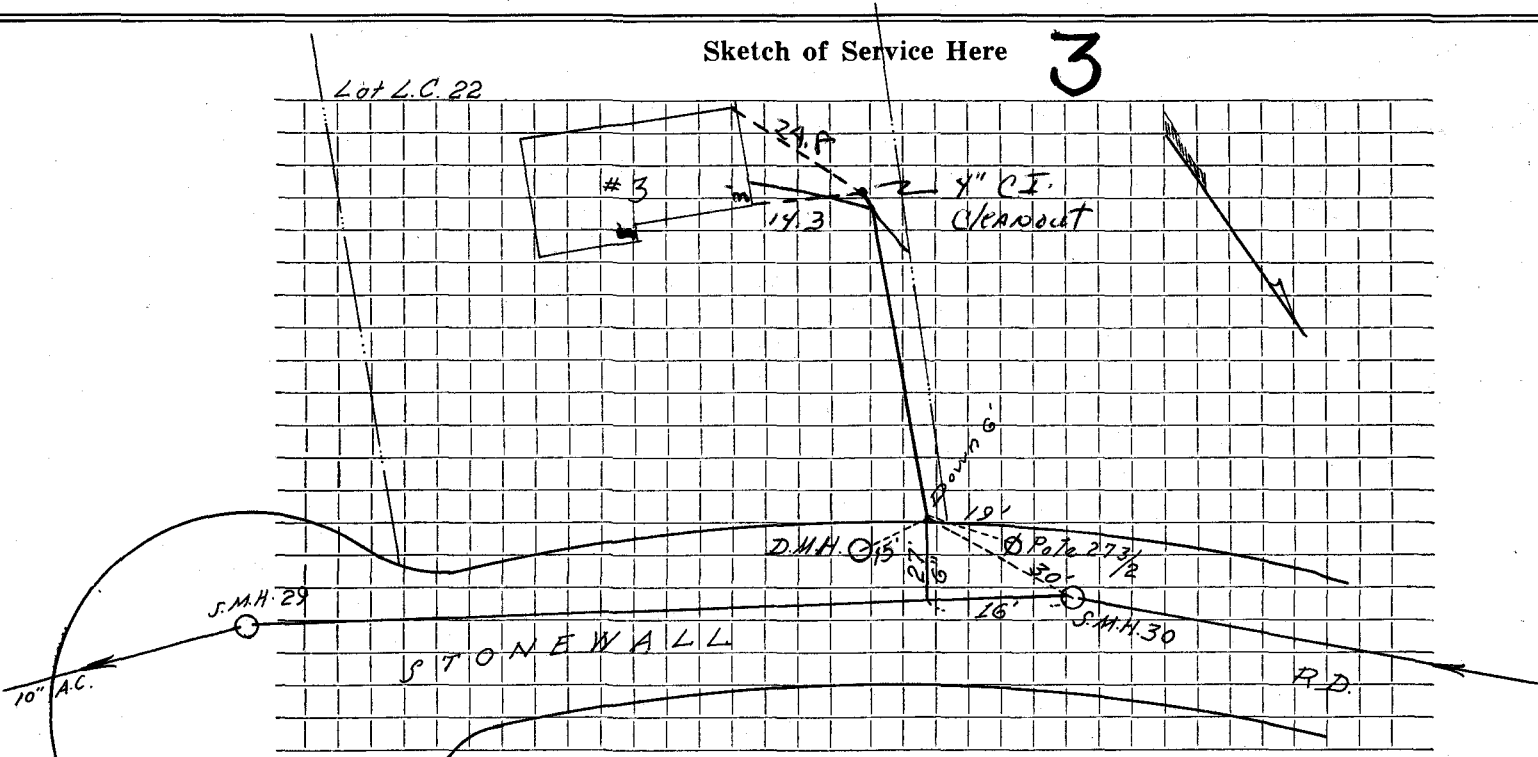

Connection made in Street. Work completed

Remarks:
.....
.....