

Name Milton Carmen  
6 Stonewall Rd.

Service No. 79

Address

6 Stonewall Rd.

Location

Lot I.C. 72

Kind of Pipe

Size 6"

Size of Main 8"

~~Repair~~ ~~Renewal~~ - New Service Sewer Man 3092


Location NOV 13 1978

Date	Material	Amount		Total	Date	Amount	
1971 85'	6" A.C. transite pipe @ 12.00	1020	00		10-26-78	Deposit	1020 00
10/25/78	185' of 6" ACP 42' of 4" CI						

DATE \_\_\_\_\_

# TOWN OF LEXINGTON — BOARD OF PUBLIC WORKS

## SEWER DIVISION

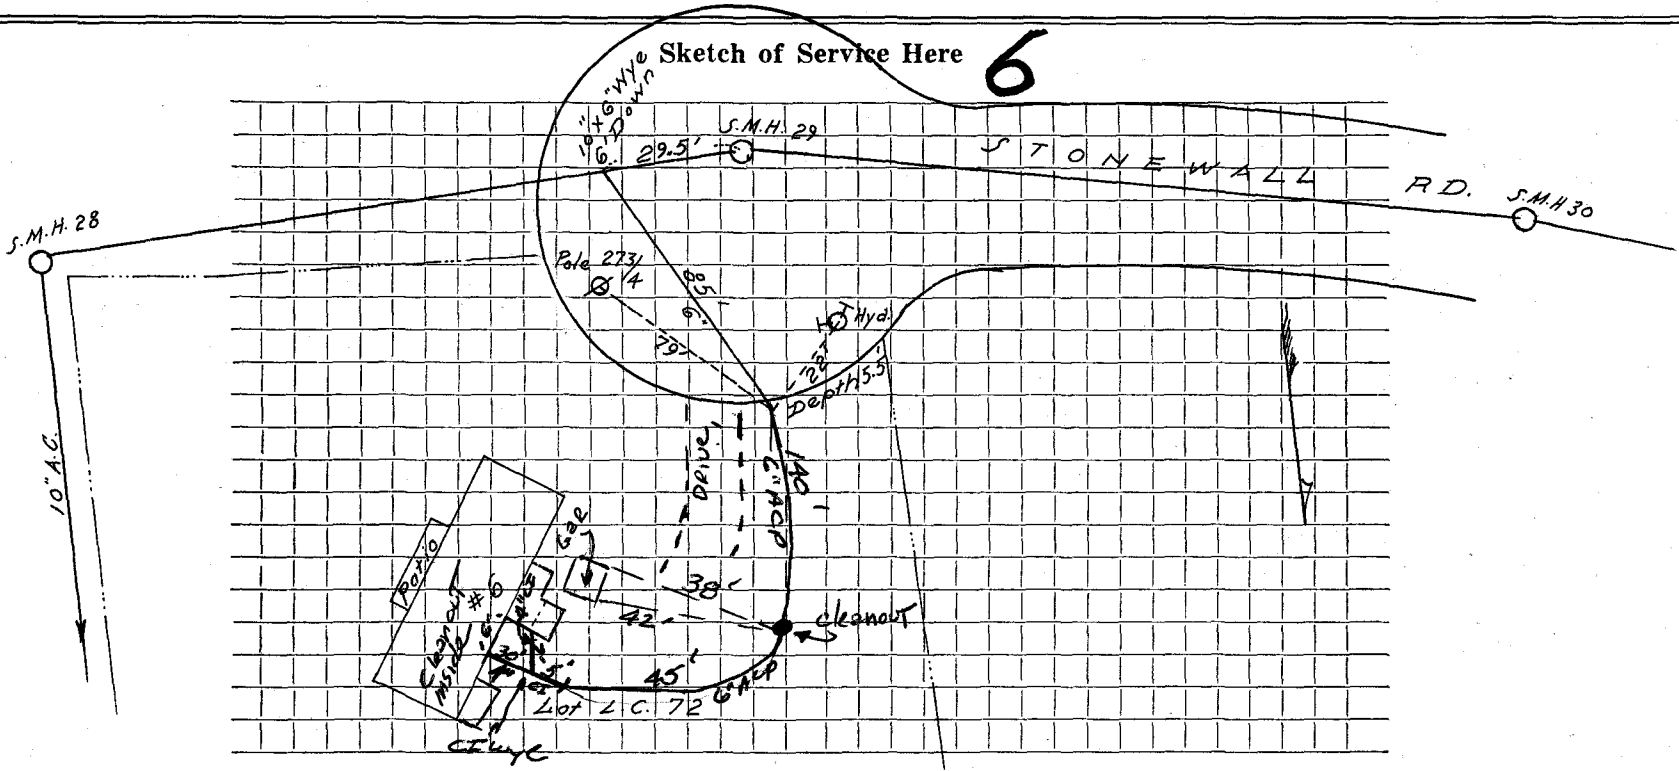

Connection made in STONEWALL R.D. Street. Work completed .....

Remarks: .....  
.....  
.....