


DATE 4-15-83

TOWN OF LEXINGTON — BOARD OF PUBLIC WORKS
SEWER DIVISION

Sketch of Service Here **10**

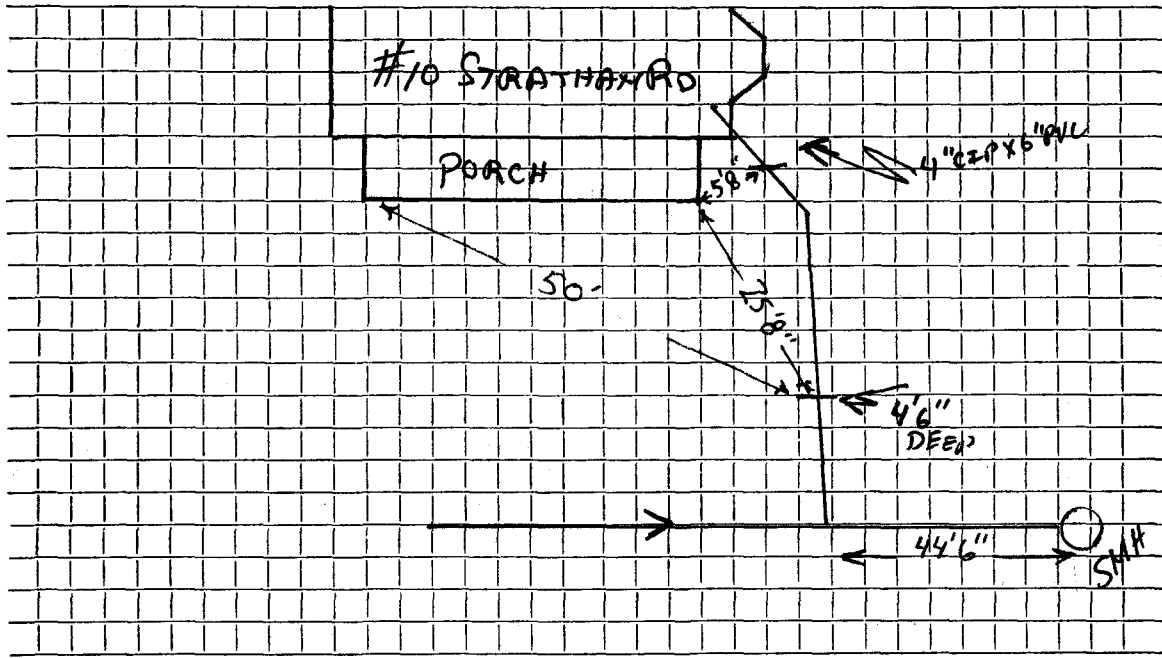

Connection made in STRATHAM RD..... Street. Work completed August 31, 1983.....

Remarks:

.....

.....