


DATE 4-15-83

TOWN OF LEXINGTON — BOARD OF PUBLIC WORKS
SEWER DIVISION

Sketch of Service Here **//**

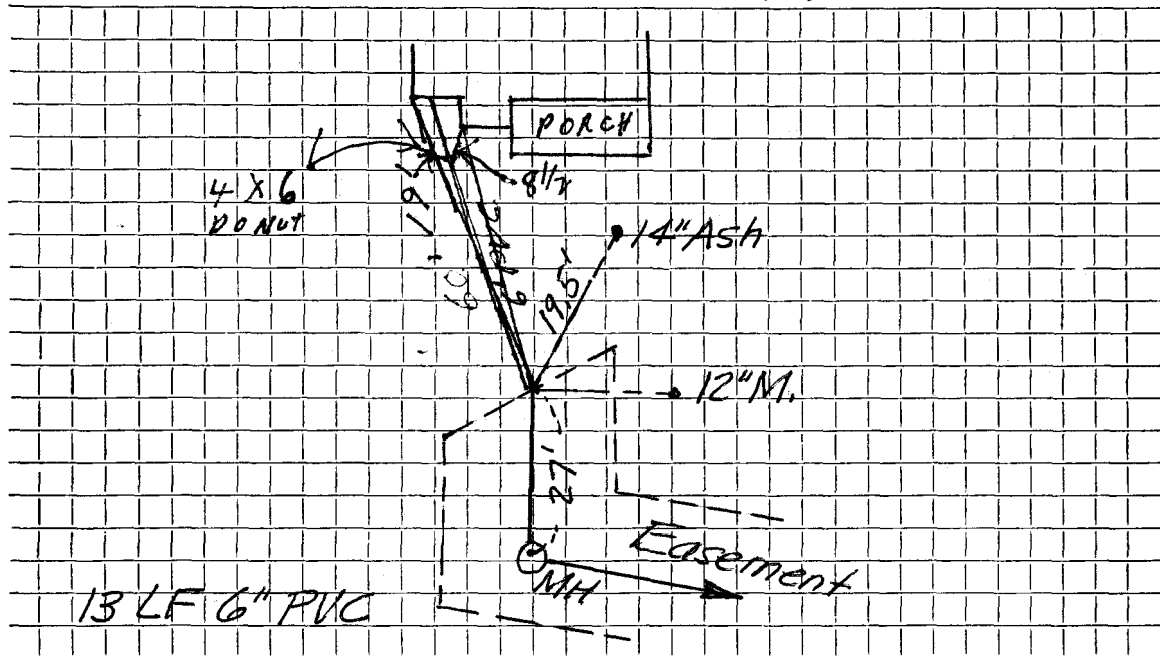

Connection made in Easement Street. Work completed

Remarks:
.....
.....