


DATE 4-15-83

TOWN OF LEXINGTON — BOARD OF PUBLIC WORKS
SEWER DIVISION

Sketch of Service Here **14**

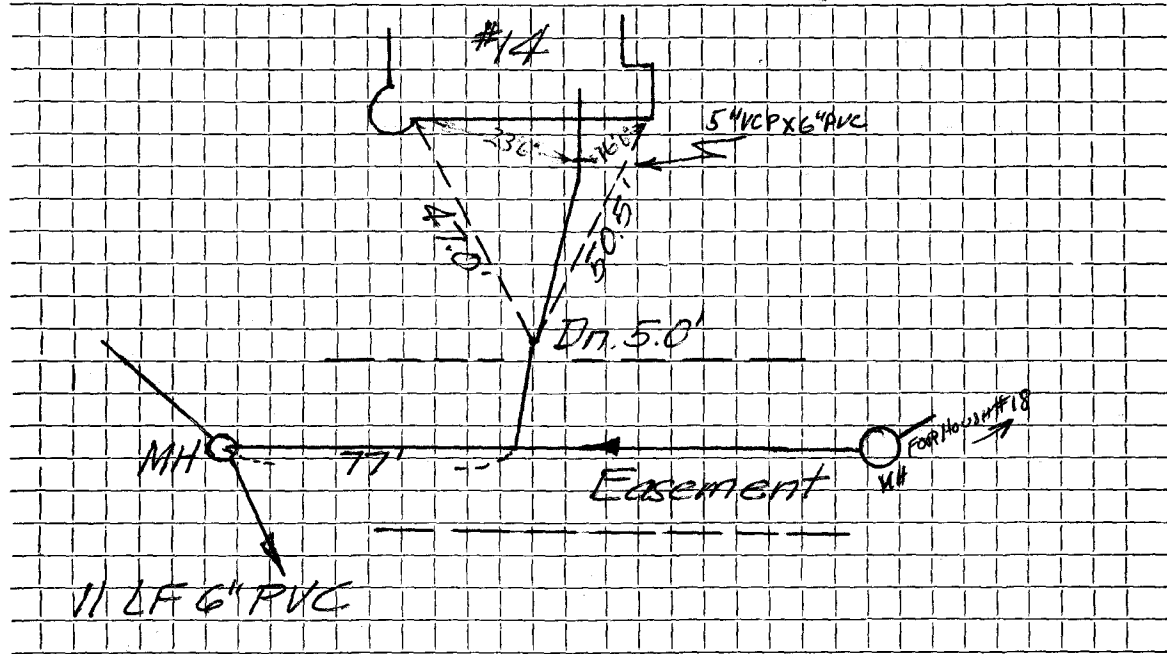

Connection made in Easement Street. Work completed Oct 20, 1983

Remarks:

.....

.....