


DATE July 14, 1983

TOWN OF LEXINGTON — BOARD OF PUBLIC WORKS
SEWER DIVISION

Sketch of Service Here

16

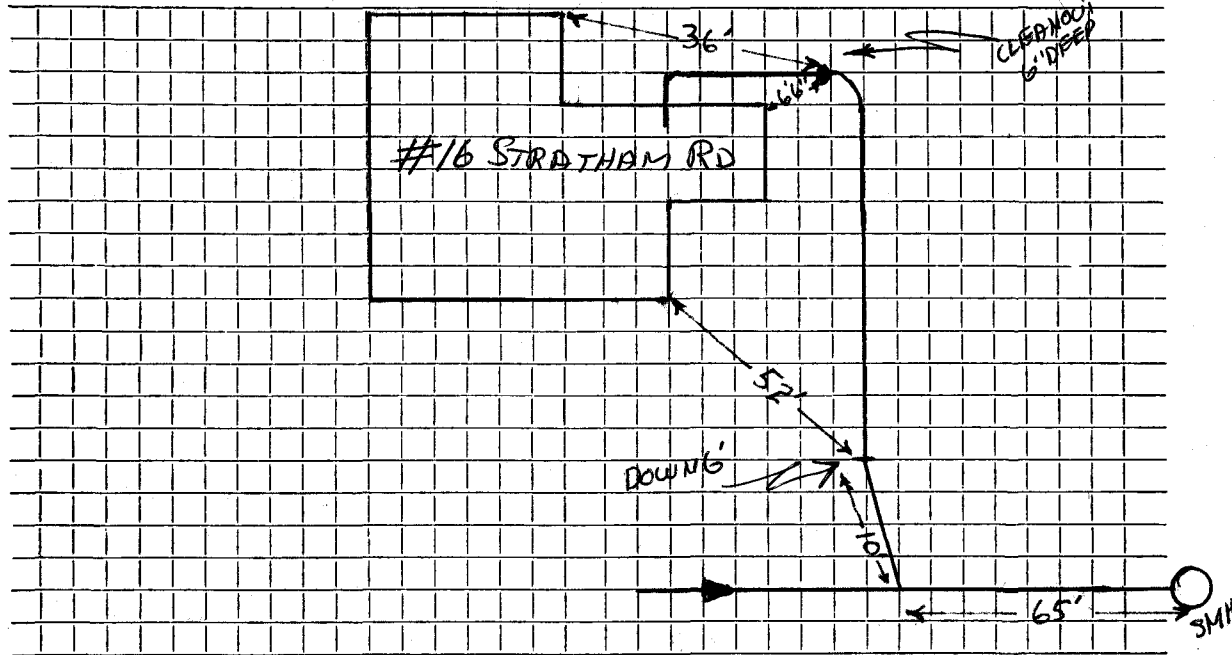

Connection made in STRATHAM ROAD Street.

Work completed Nov 30, 1983

Remarks: