


DATE 7-14-83

TOWN OF LEXINGTON — BOARD OF PUBLIC WORKS

SEWER DIVISION

Sketch of Service Here **19**

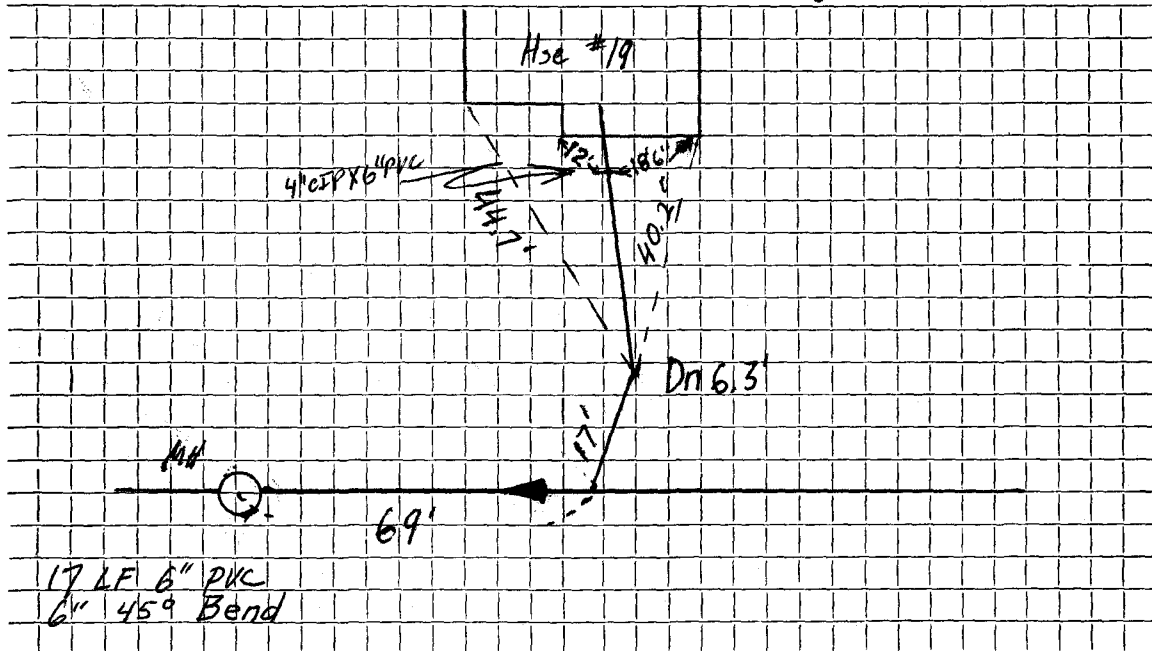

Connection made in ... STRATHAM ROAD Street. Work completed Oct. 28, 1983

Remarks:

.....

.....