




DATE 4-15-83

TOWN OF LEXINGTON — BOARD OF PUBLIC WORKS  
SEWER DIVISION

Sketch of Service Here

2

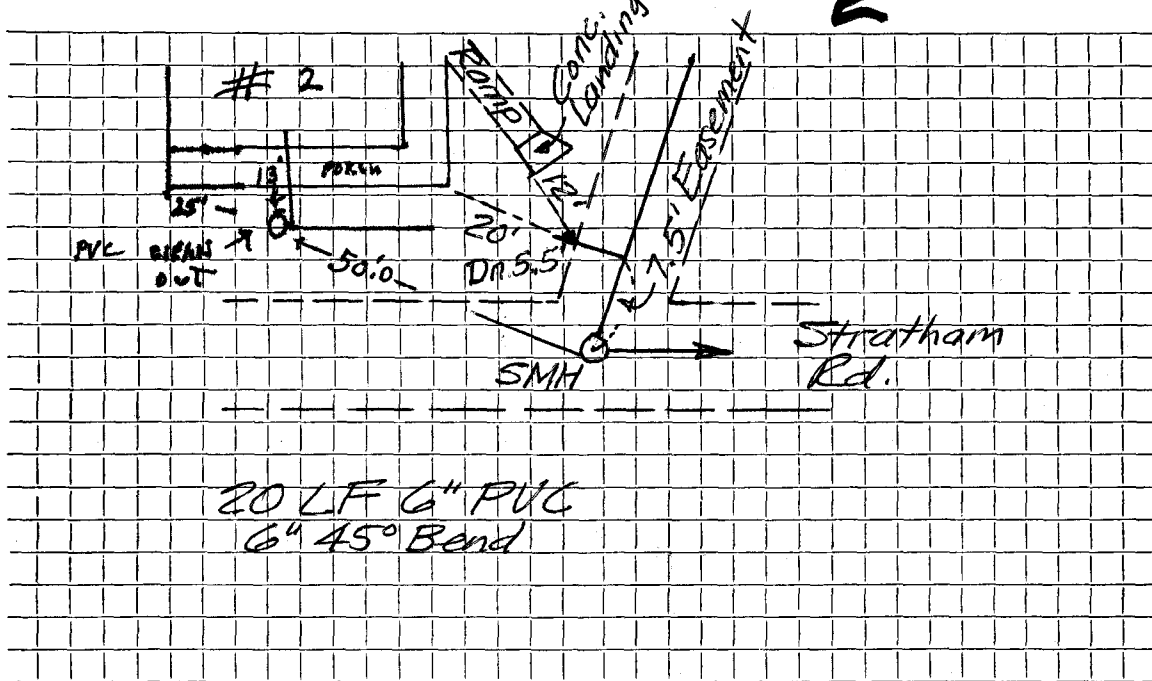

Connection made in Easement ~~Street~~ Work completed .....

Remarks: .....

.....

.....