


DATE 10/28/83

TOWN OF LEXINGTON — BOARD OF PUBLIC WORKS
SEWER DIVISION

Sketch of Service Here **8**

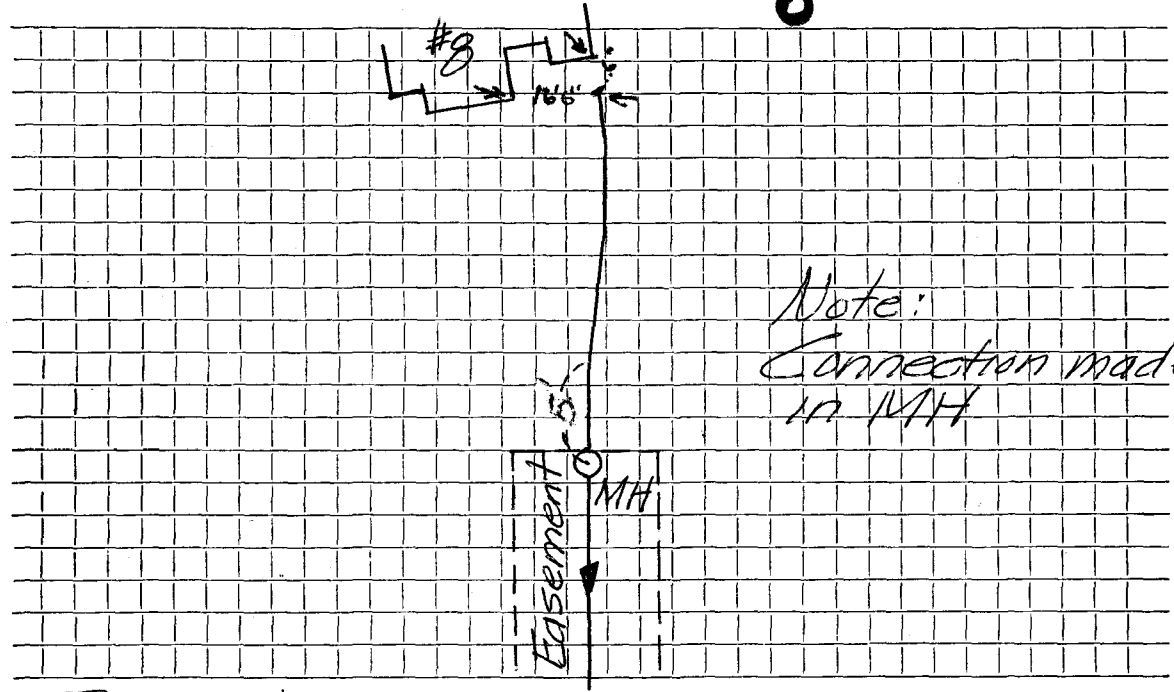

Note:
Connection made
in MH

Connection made in Easement Street. Work completed

Remarks: