

Name _____

Service No.

Address

12 Sullivan ST.

Location

Kind of Pipe PVC

Size 6" PVC

Size of Main 8" AC

Repair Renewal New Service

UPGRADE ~~to cloughlin~~


Location

DATE _____

TOWN OF LEXINGTON — BOARD OF PUBLIC WORKS

SEWER DIVISION

Sketch of Service Here

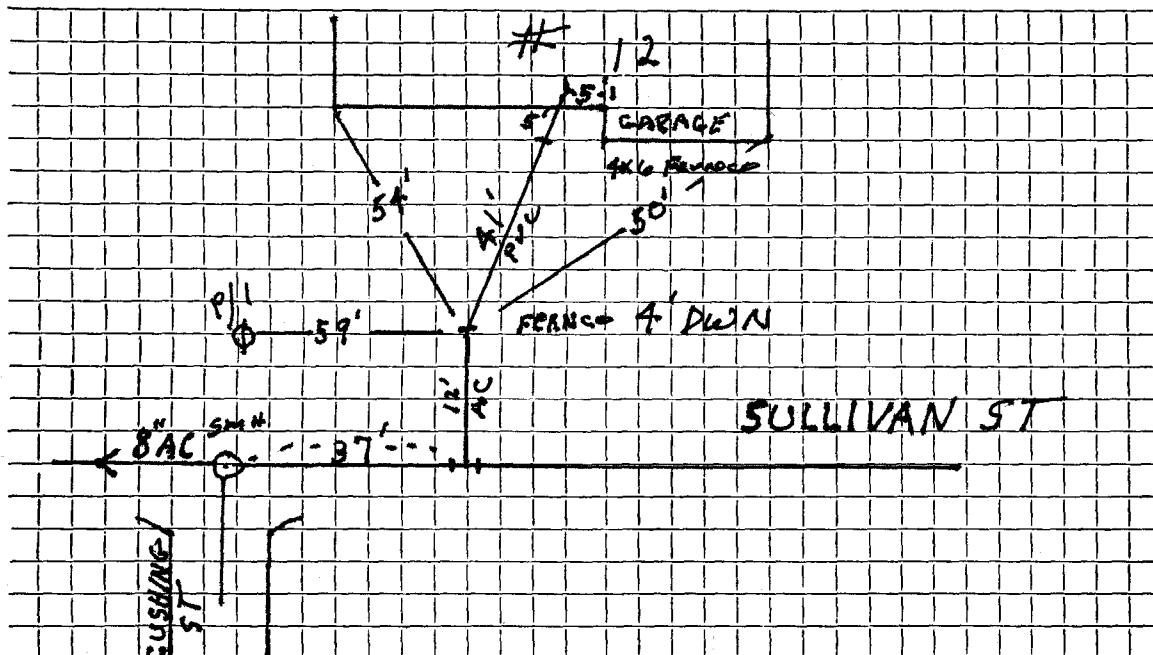

Connection made in Street. Work completed

Remarks: