

Name \_\_\_\_\_

**Service No.**

**Address** UNIT #10 SULLIVAN ST IS NO 26

## **Location**

**Kind of Pipe PVC**

**Size 6"**

### **Size of Main**

**Repair—Renewal—New Service**


#### **Location**

DATE \_\_\_\_\_

TOWN OF LEXINGTON — BOARD OF PUBLIC WORKS  
SEWER DIVISION

Sketch of Service Here

NO 26

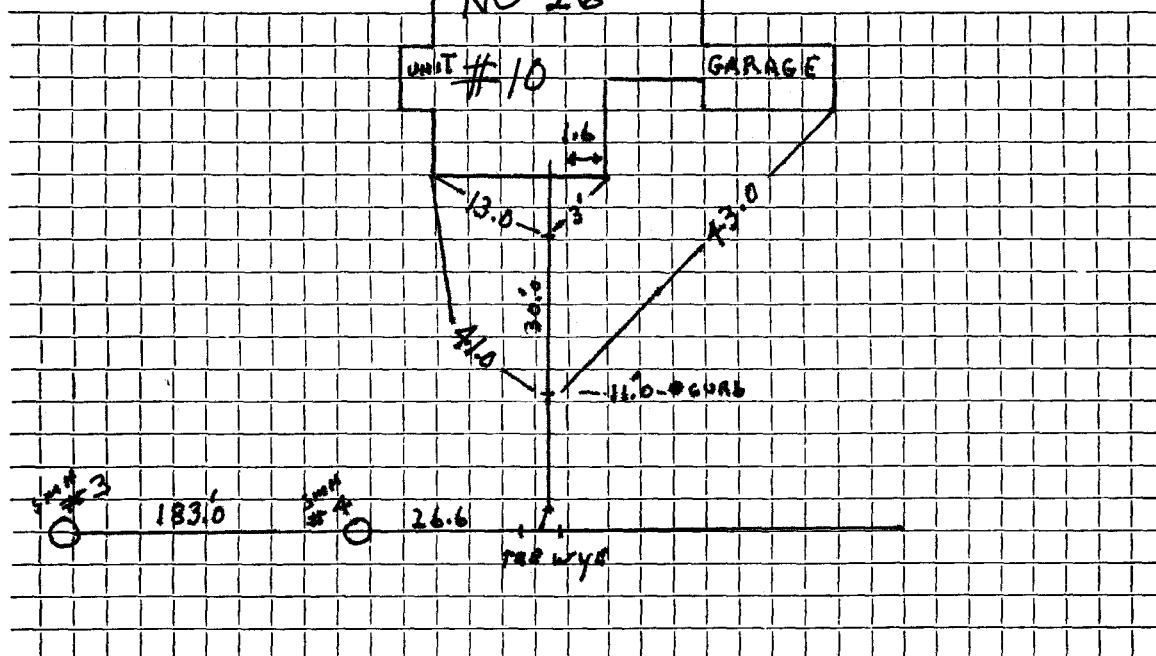

Connection made in ..... Street. Work completed JAN 2001 .....

Remarks: .....