




DATE \_\_\_\_\_

TOWN OF LEXINGTON — BOARD OF PUBLIC WORKS  
SEWER DIVISION

Sketch of Service Here  
NO 28

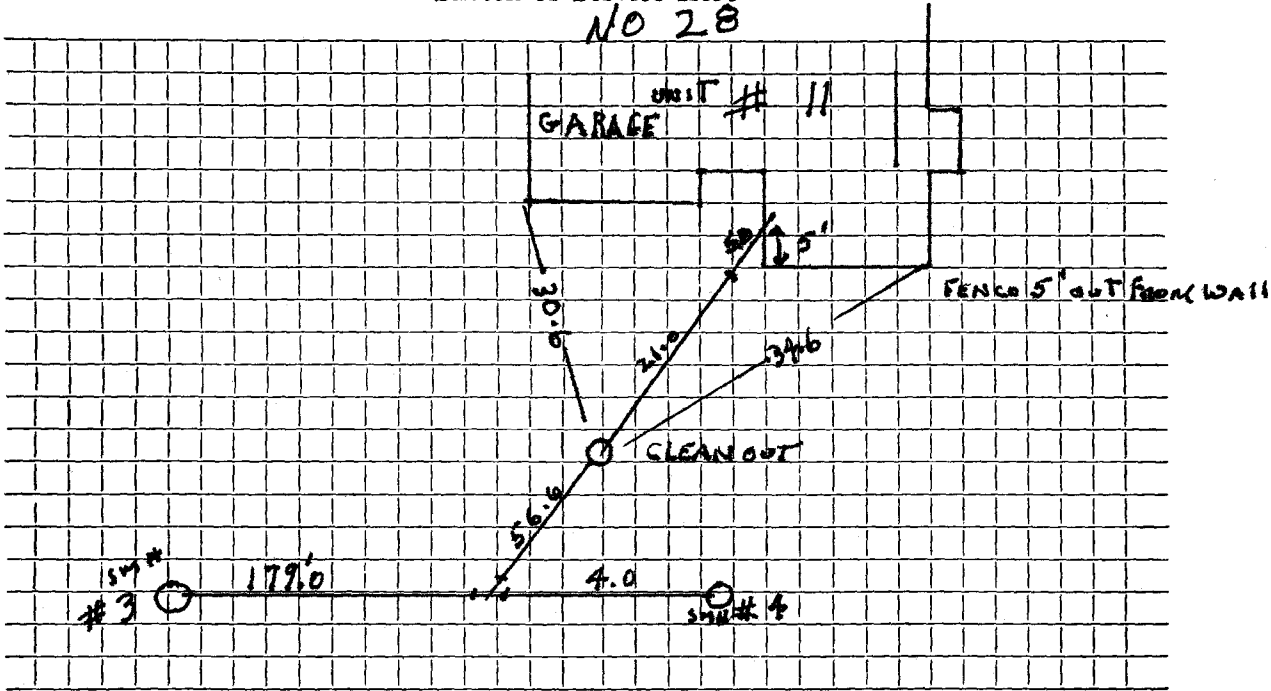

Connection made in ..... Street. Work completed DEC 2000 .....


Remarks: .....  
.....  
.....



DATE 9-24-2001

TOWN OF LEXINGTON — BOARD OF PUBLIC WORKS  
SEWER DIVISION

Sketch of Service Here

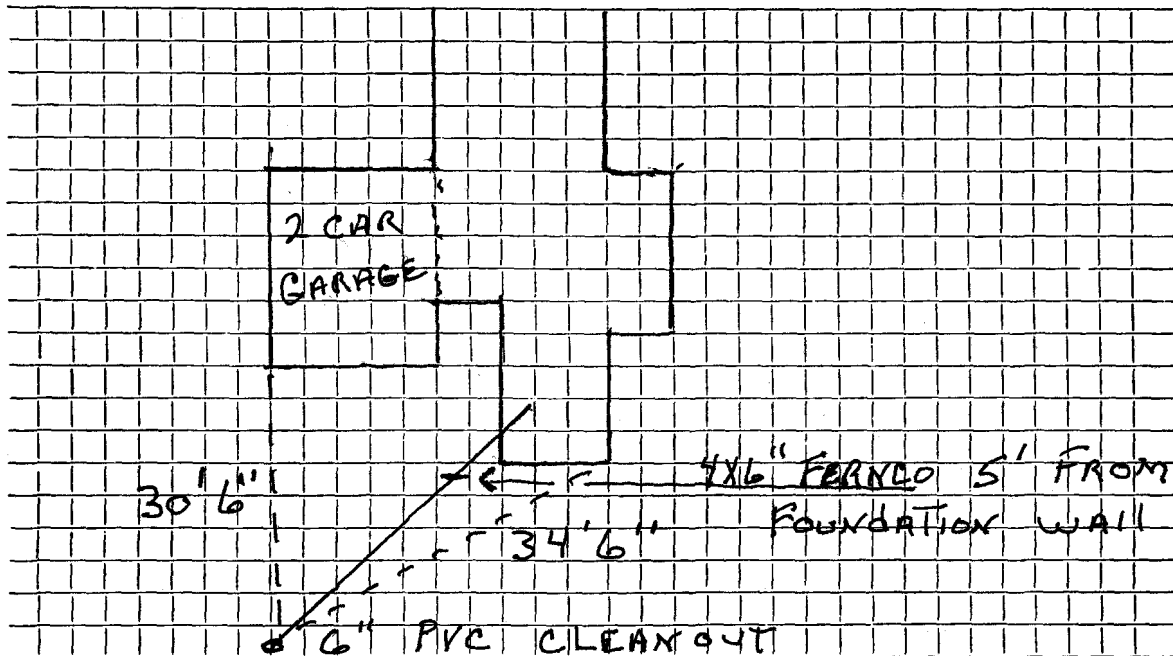

Connection made in ... SULLIVAN ..... Street. Work completed .....

Remarks: .. NEW ... SUB ... DIVISION .....

INSTALLED BY J. McLAUGHLIN .....