


DATE _____

TOWN OF LEXINGTON — BOARD OF PUBLIC WORKS
SEWER DIVISION

Sketch of Service Here
NO 32

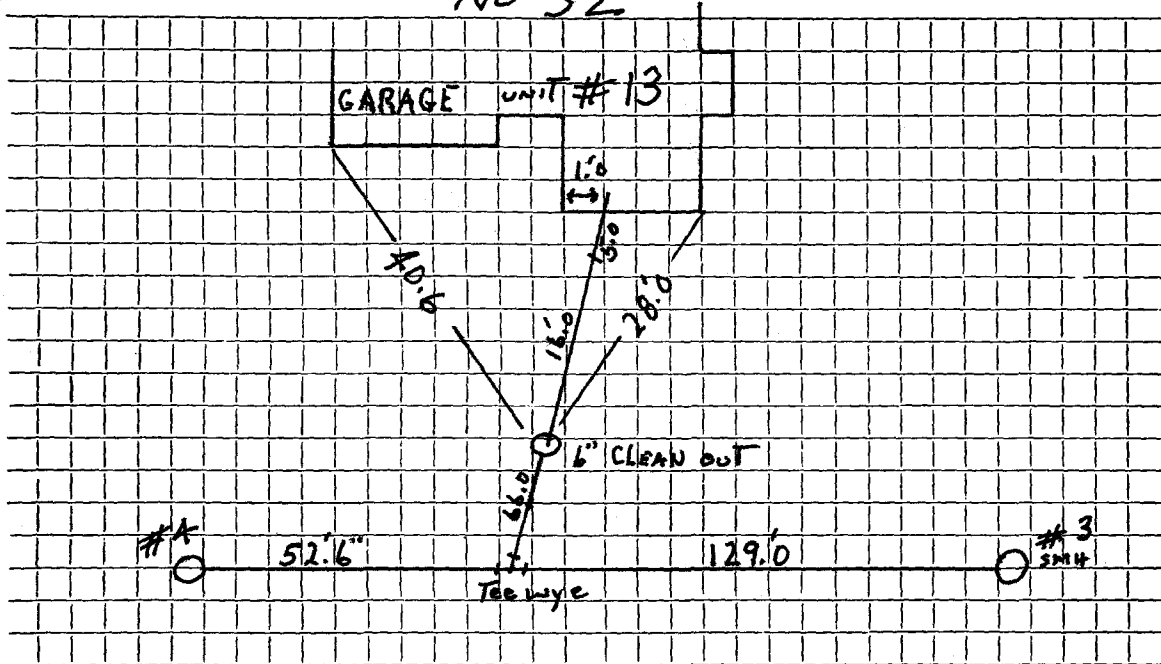

Connection made in Street. Work completed NOV. 2000

Remarks:

.....

.....