


DATE _____

TOWN OF LEXINGTON — BOARD OF PUBLIC WORKS
SEWER DIVISION

Sketch of Service Here

SULLIVAN ST

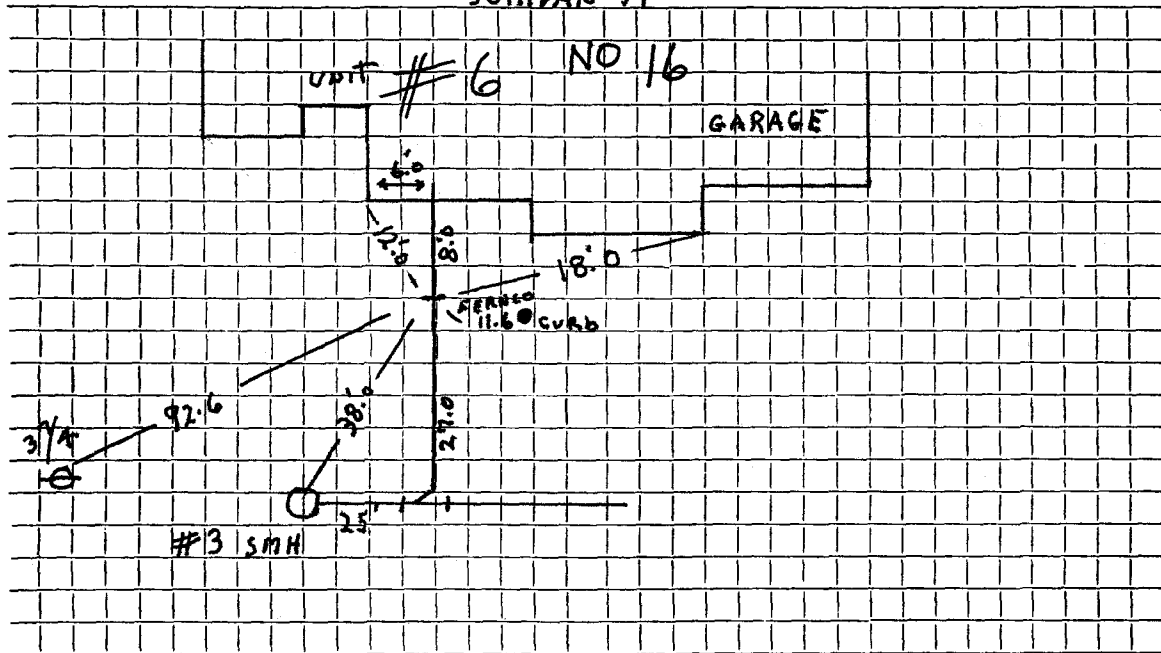

Connection made in Street. Work completed Aug 2001

Remarks:

.....

.....