

Name

Service No.

Address UNIT 7 SULLIVAN STIS No 18

Location

Kind of Pipe PVC

Size 6"

Size of Main

Repair—Renewal—(New) Service J McInerney


Location

Date	Material	Amount	Total	Date	Amount
NOV-2001 756	6" PVC				
5'	4" PVC				
	4X6 Franco				
	8X6 WYE				

DATE _____

TOWN OF LEXINGTON — BOARD OF PUBLIC WORKS
SEWER DIVISION

Sketch of Service Here

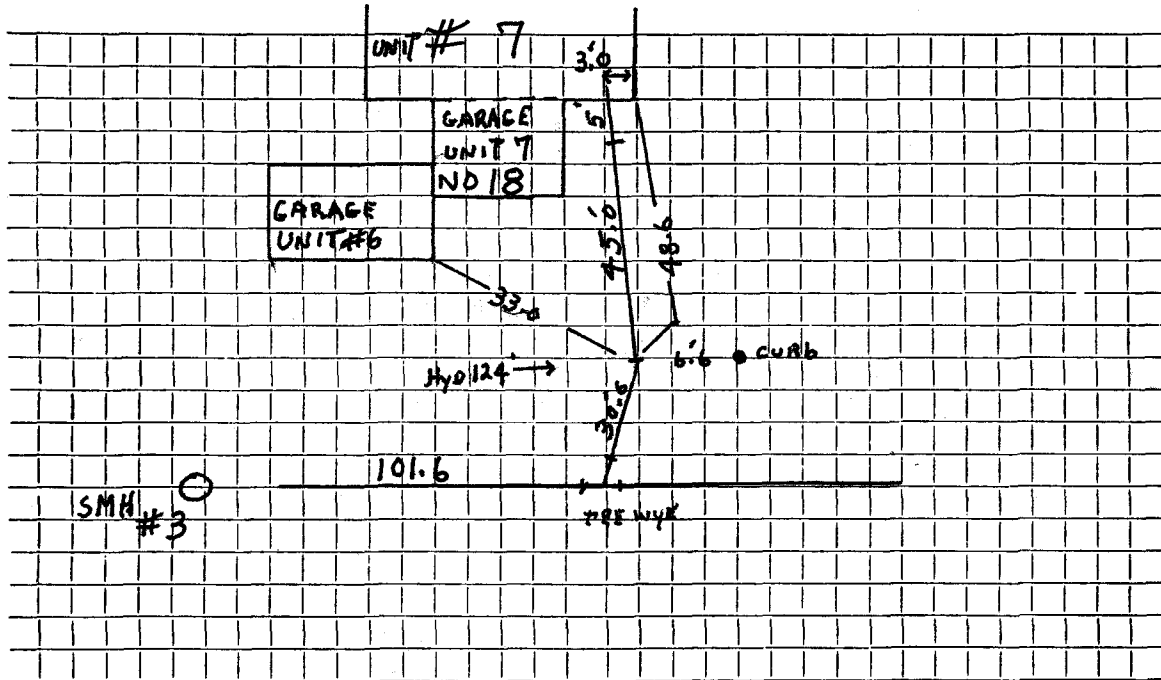

Connection made in Street. Work completed NOV 2001

Remarks:

.....

.....