

Name

Service No.

Address # 10 SUMMER STREET

10 SUMMER STREET

Kind of Pipe

Size 6"

Location

Size of Main 8"

Repair—Renewal—New Service

Location


Date	Material	Amount	Total	Date	Amount
9-18-75	31' - 6" ACP	10 00	310 00		

DATE _____

TOWN OF LEXINGTON — BOARD OF PUBLIC WORKS

SEWER DIVISION

Sketch of Service Here **10**

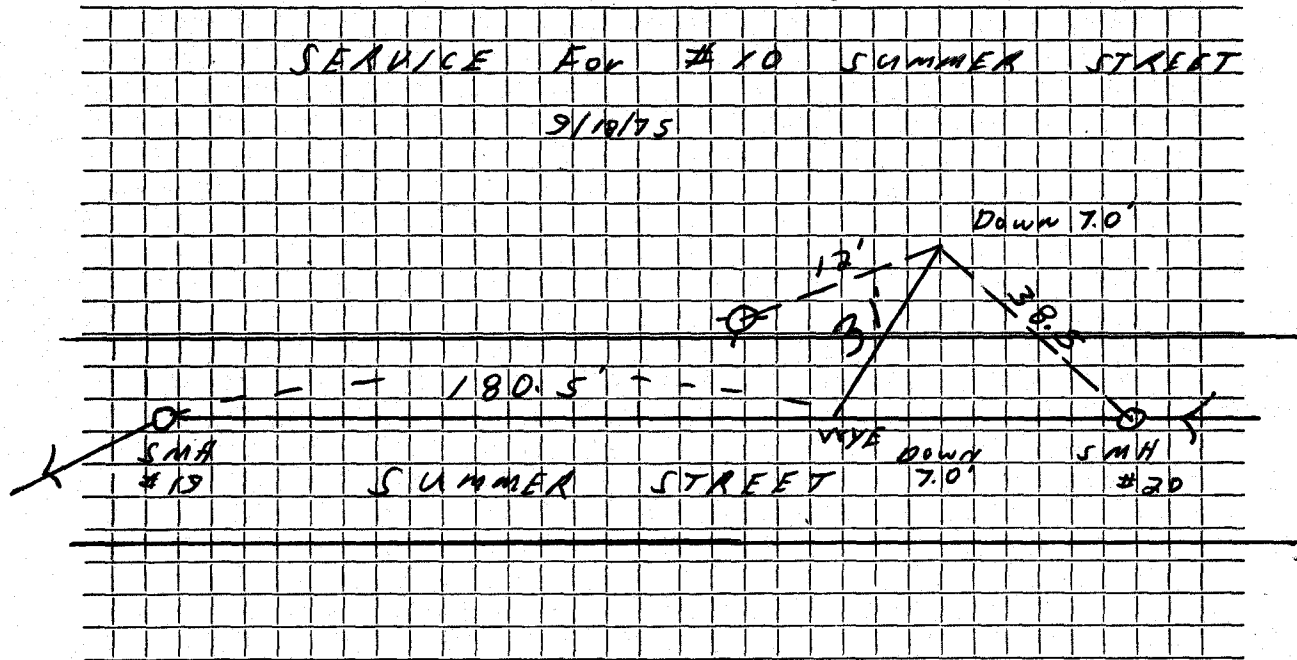

Connection made in SUMMER Street. Work completed

Remarks:

.....

.....