

Name HOWARD TARLOW

Service No.

Address #10A SUMMER STREET

10A Summer Street

Location

Kind of Pipe

Size 6"

Size of Main 8"

Repair—Renewal

New Service

PERMIT NO. 0434 McLaughlin


Location

Date	Material	Amount	Total	Date		Amount
1995	295' 6" PVC					
				9-12-75		
					38' 6" Transite	

DATE 15 MARCH 1995

TOWN OF LEXINGTON — BOARD OF PUBLIC WORKS
SEWER DIVISION

Sketch of Service Here **10A**

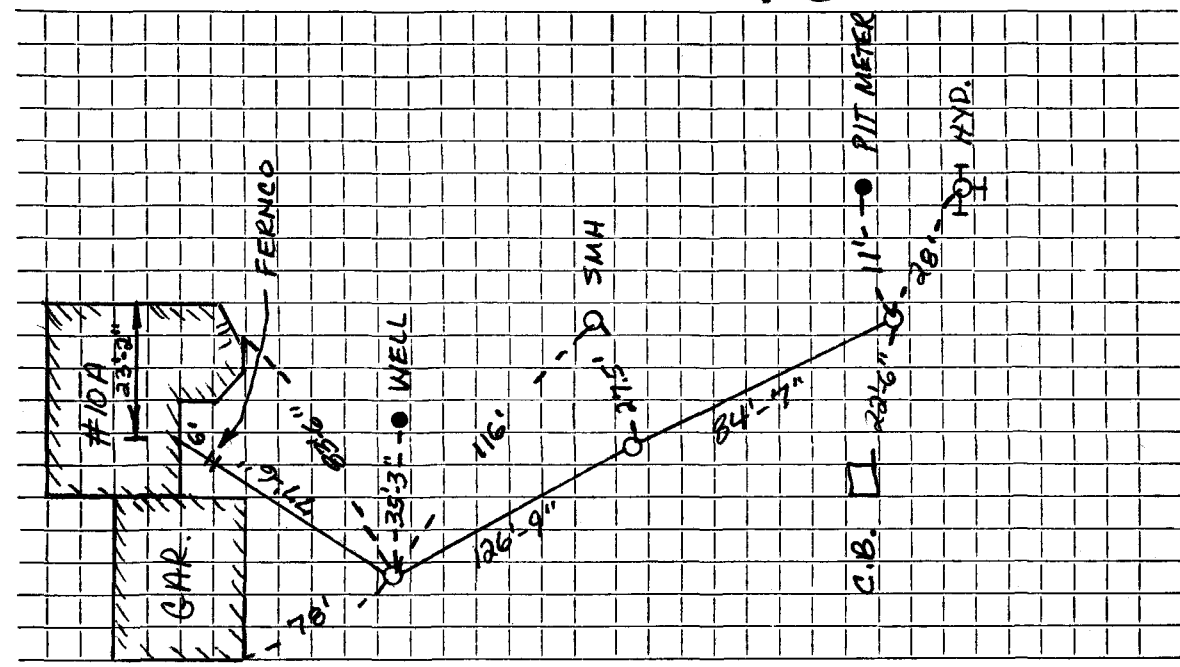

Connection made in SUMMER STREET Street. Work completed J.M. MCLAUGHLIN

Remarks:

.....

.....