

Name

Service No.

Address

12 Summer St

Location

Kind of Pipe

Size

Size of Main

Repair—Renewal—New Service

Location

Date

Material

Amount

Total

Date

Amount

7-24-01

Inside installed
but not hooked up

79'-6" PVC


6-13-02

SERVICE CONNECTED
to house
5x6 EI to PVC FERNCO
2-6" 220 BANDS
13'6"-6" PVC

DATE _____

TOWN OF LEXINGTON — BOARD OF PUBLIC WORKS

SEWER DIVISION

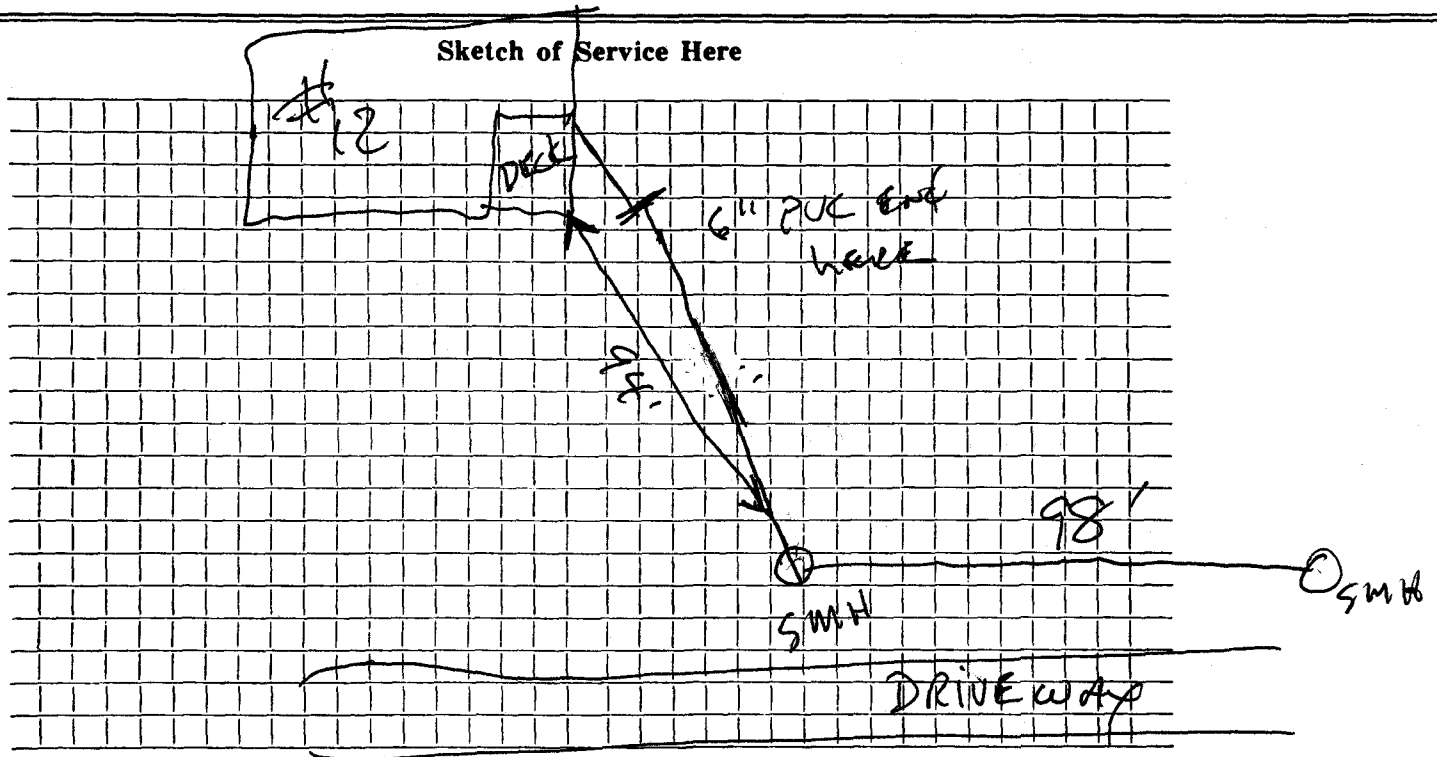

Connection made in Street. Work completed

Remarks: SERVICE CONNECTED INTO M.H.
..... just to right of driveway for #10 sewer
..... see tie card for #10