


DATE _____

TOWN OF LEXINGTON — BOARD OF PUBLIC WORKS

SEWER DIVISION

Sketch of Service Here

SERVICE FOR # 16 Summer street

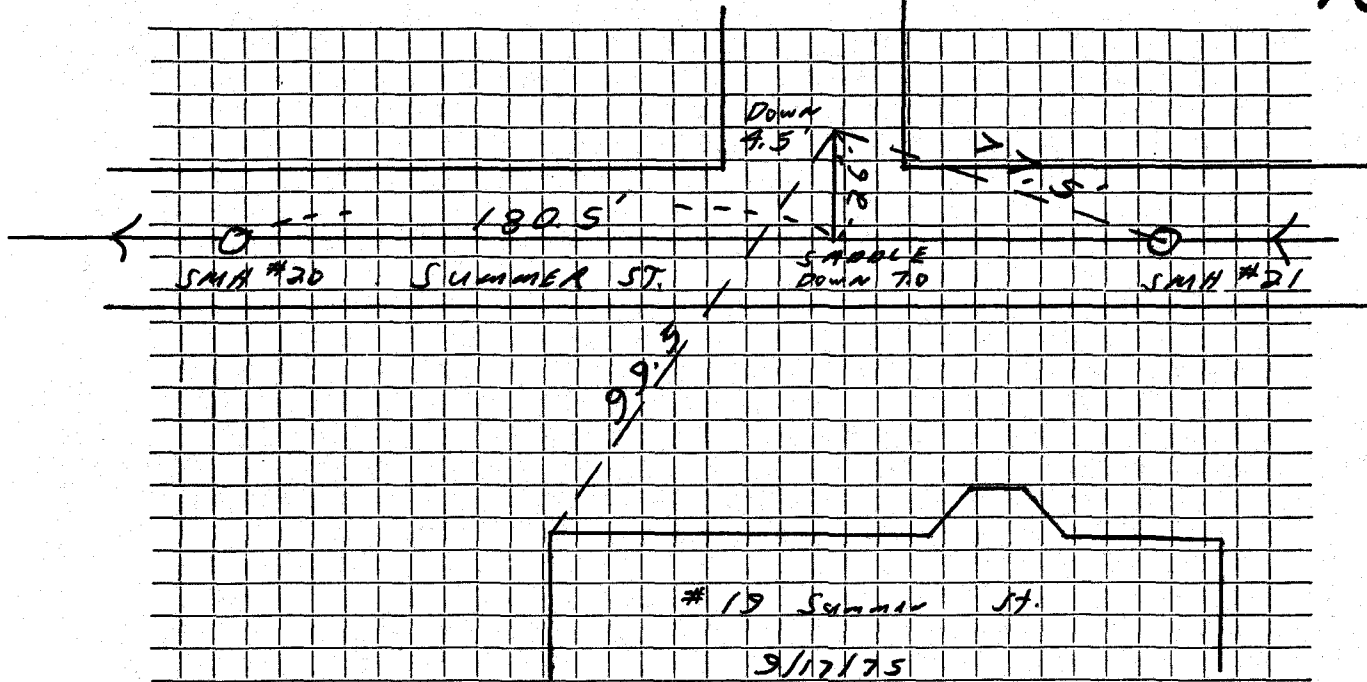

Connection made in SUMMER Street. Work completed

Remarks:
.....
.....