

Service No.

Name

Address 19 Summer Street

19 Summer Street

Location

Kind of Pipe AC

Size 6"

Size of Main 8"

Repair—Renewal—New Service


Location

Date	Material	Amount	Total	Date	Amount
9-17-75	22'-6" AC at	\$10.00 =	\$220.00		

DATE _____

TOWN OF LEXINGTON — BOARD OF PUBLIC WORKS
SEWER DIVISION

Sketch of Service Here **19**

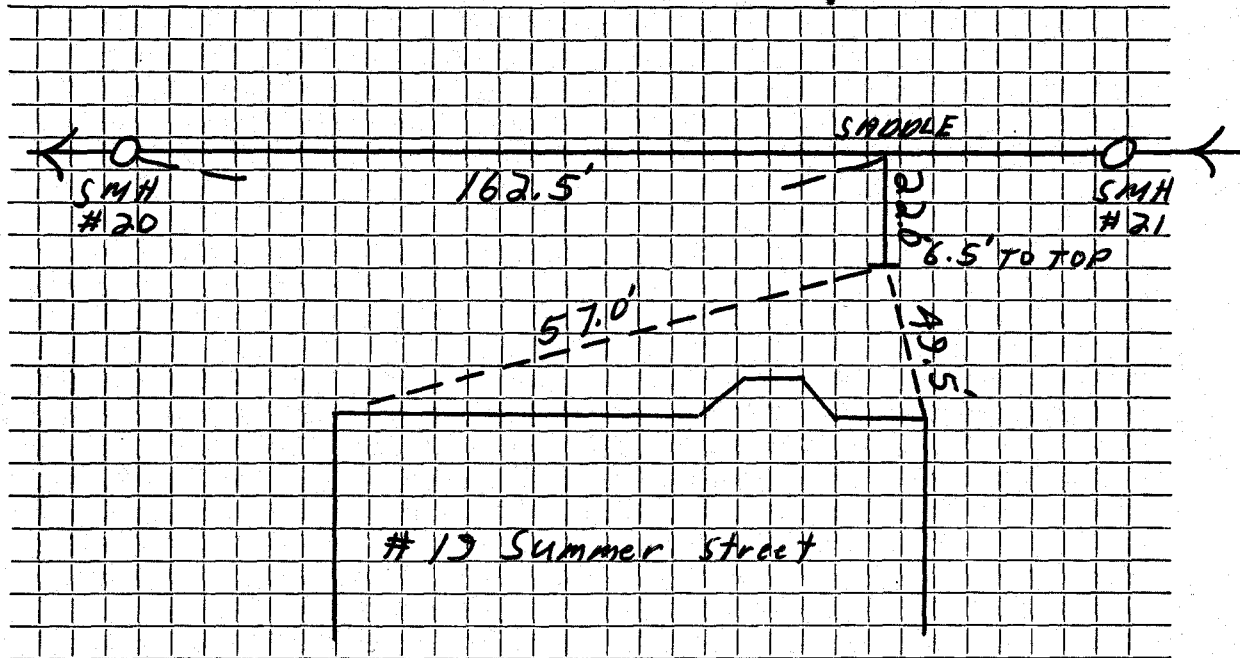

Connection made in Summer Street. Work completed

Remarks:
.....
.....