

Name Livingstone Selman

Service No. 32

Address # 25 SUMMER STREET

25 Summer Street

Location

Kind of Pipe

Size 6"

Size of Main 8"

~~Wastewater~~-New Service Valeri #3506A

Location SEP 8 1980


Date	Material	Amount	Total	Date	Amount
9-22 75	26' - 6" A.C.P.	10 00	260 00	8-11-80	Deposit 260 00
9/12/80 12	5' x 6" Transite Nipple				
1	3' x 6" Transite Nipple				
1	1 1/4" Sweep				
2	2 1/2" Sweep				
1	Donut				

DATE \_\_\_\_\_

TOWN OF LEXINGTON — BOARD OF PUBLIC WORKS

SEWER DIVISION

Sketch of Service Here **25**

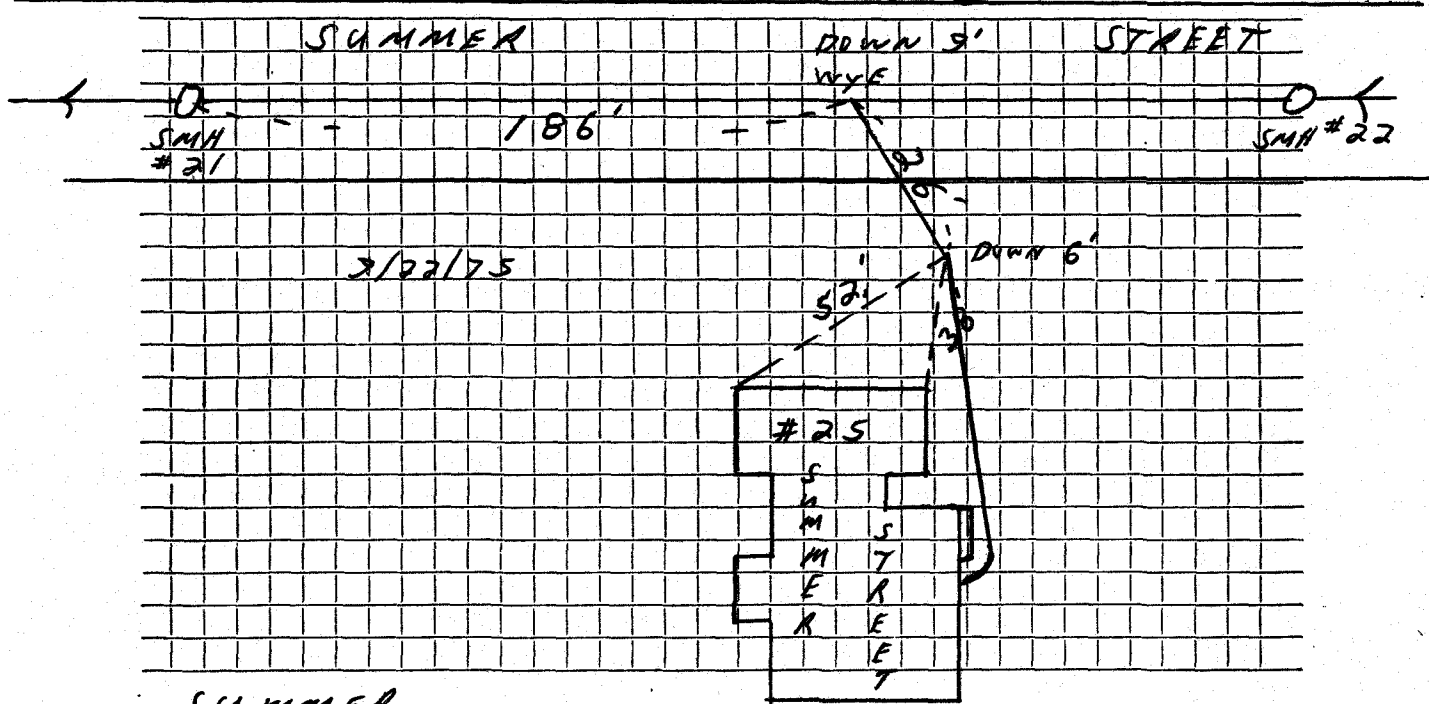

Connection made in SUMMER Street. Work completed .....

Remarks: .....  
.....  
.....