






DATE \_\_\_\_\_

TOWN OF LEXINGTON — BOARD OF PUBLIC WORKS  
SEWER DIVISION

Sketch of Service Here **27**

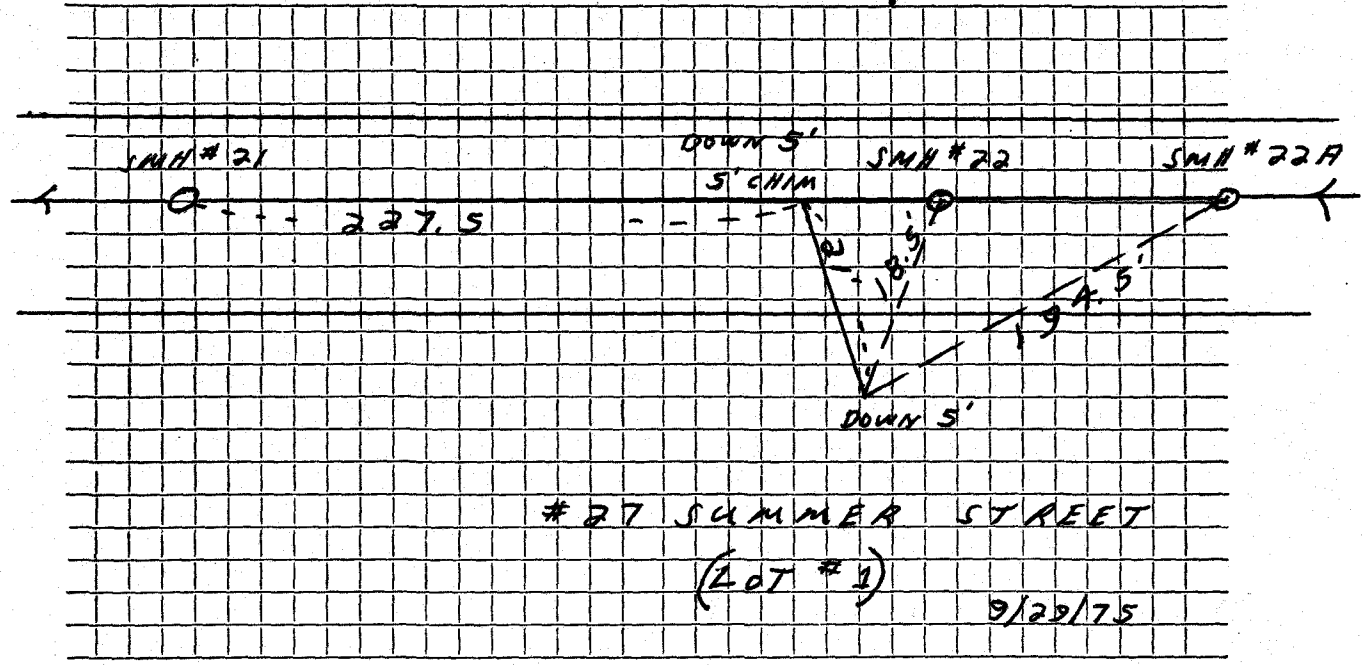


Connection made in SUMMER Street. Work completed .....

Remarks: .....  
.....  
.....

DATE MARCH 17 1998

TOWN OF LEXINGTON — BOARD OF PUBLIC WORKS  
SEWER DIVISION

Sketch of Service Here

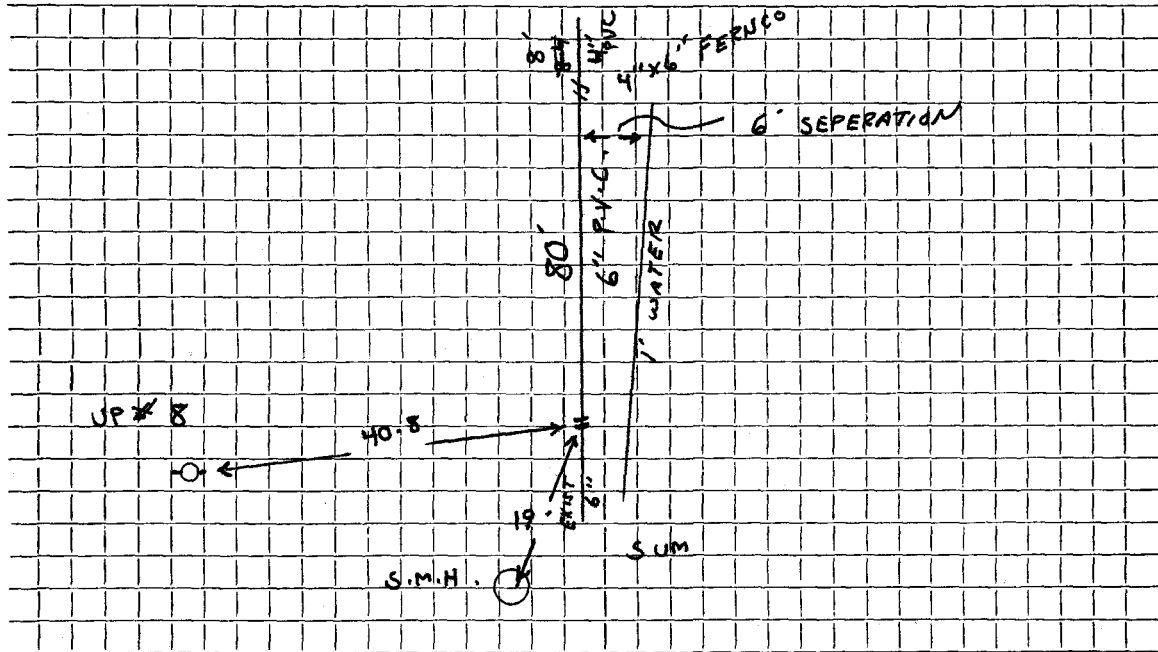

Connection made in SUMMER ST. Street. Work completed J.M. McLAUGHLIN

Remarks: NO FOUNDATION IN AT TIME OF INSPECTION

FIELD BOOK 98-1 TJM