

Name

Service No.

Address #31 SUMMER STREET

31 Summer Street

Location

Kind of Pipe

Size 6"

Size of Main 8"

Repair—Renewal—New Service

Location

Date		Material	Amount		Total		Date	Amount	
9-30	75	21'-6" A.C.P.	10	00	210	00			


J.S.A. 18908

DATE _____

TOWN OF LEXINGTON — BOARD OF PUBLIC WORKS

SEWER DIVISION

Sketch of Service Here **31**

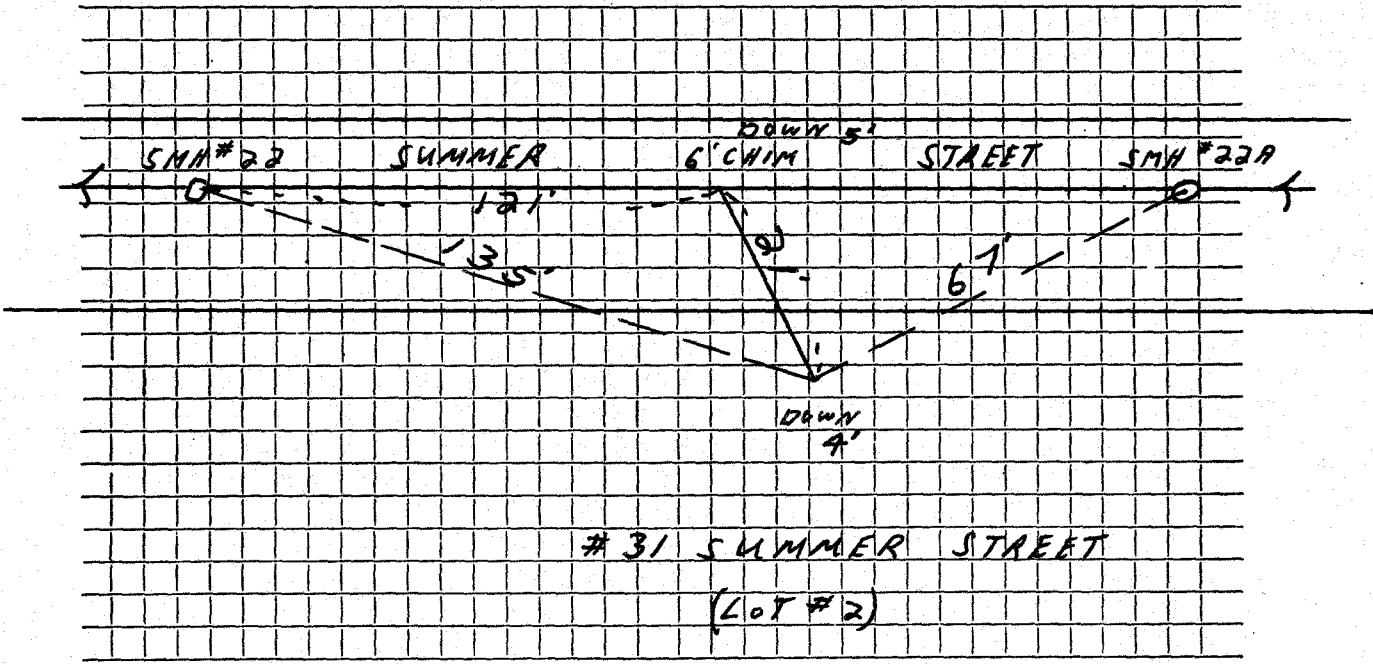


Connection made in SUMMER Street. Work completed

Remarks:
.....
.....

DATE APRIL 15 1998

TOWN OF LEXINGTON — BOARD OF PUBLIC WORKS
SEWER DIVISION

Sketch of Service Here

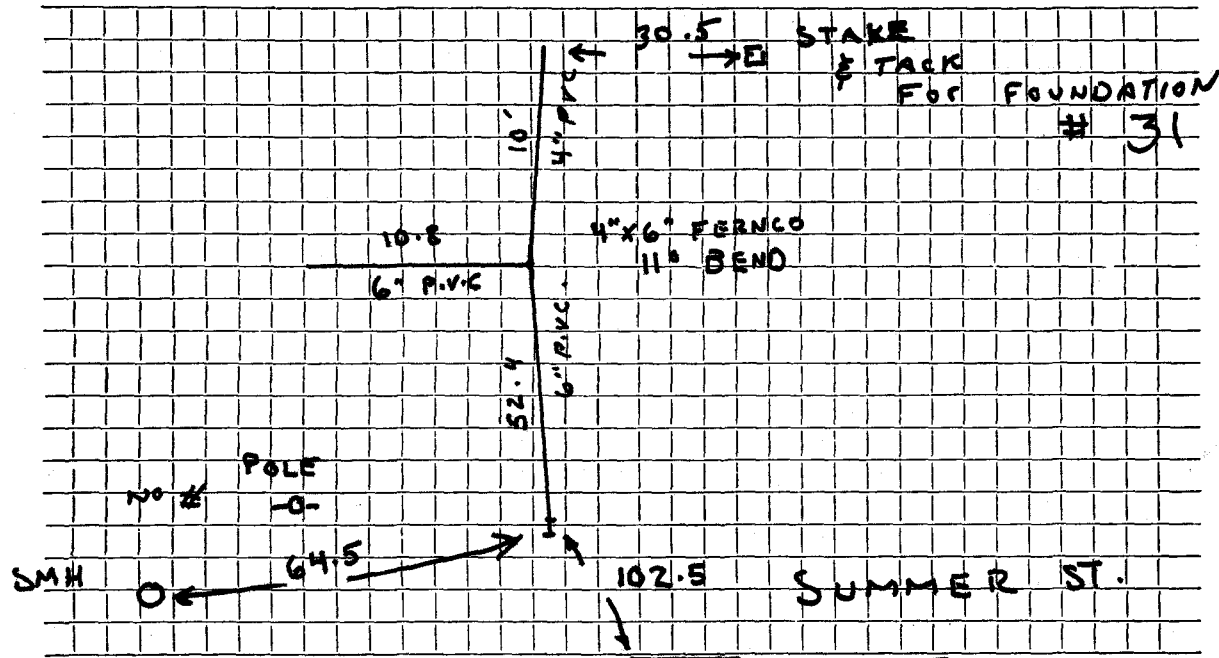

Connection made in SUMMER Street. Work completed S.M. McLAUGHLIN

Remarks: FOUNDATION NOT FINISHED WHEN INSPECTION WAS DONE