


DATE _____

TOWN OF LEXINGTON — BOARD OF PUBLIC WORKS
SEWER DIVISION

Sketch of Service Here **33**

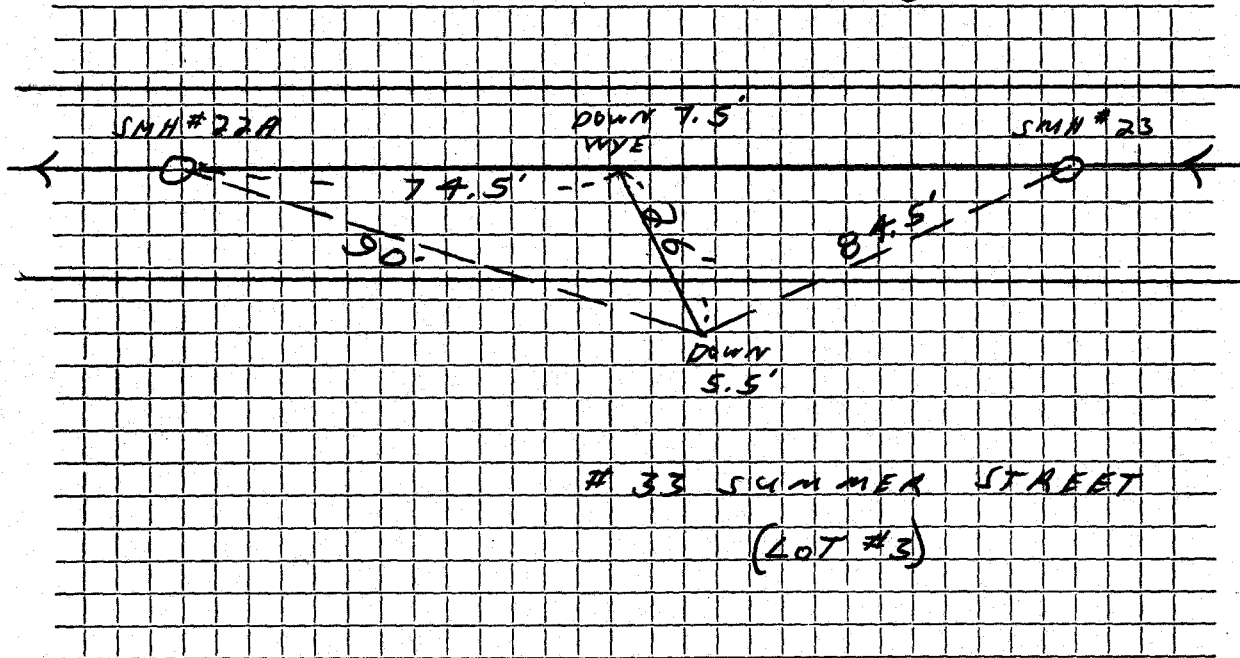


Connection made in SUMMER Street. Work completed

Remarks:
.....
.....

DATE MARCH 25 1998

TOWN OF LEXINGTON — BOARD OF PUBLIC WORKS
SEWER DIVISION

Sketch of Service Here

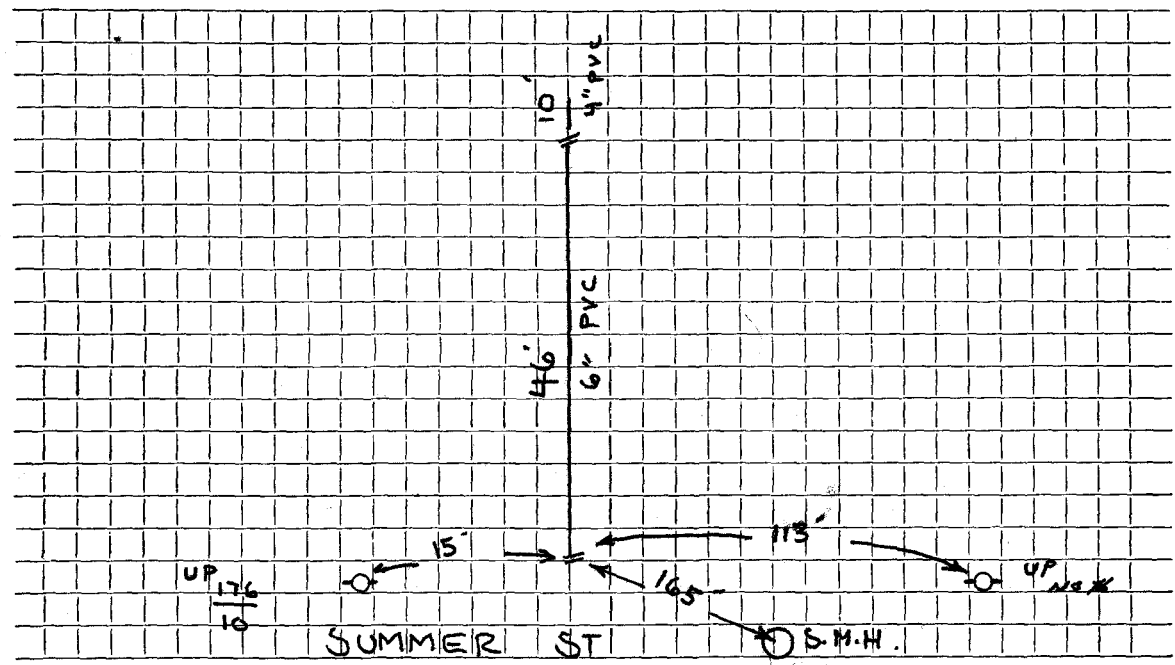

Connection made in .SUMMER. ST. Street. Work completed ... J.M. ... M.C. LAUGHLIN

Remarks: NO.. FOUNDATION.. AT.. TIME.. OF.. INSPECTION

FIELD BOOK 98-1

TJM