

Service No.

Lot # 6

Name
Address 37 SUMMER STREET

Location
37 Summer Street

Size of Main 8"

Size 6"

Kind of Pipe AC

Location

Repair—Renewal—New Service


Date	Material	Amount	Total	Date	Amount
9-25-75	31'-6" AC at	10.00 =	310.00		

DATE _____

TOWN OF LEXINGTON — BOARD OF PUBLIC WORKS

SEWER DIVISION

Sketch of Service Here **37**

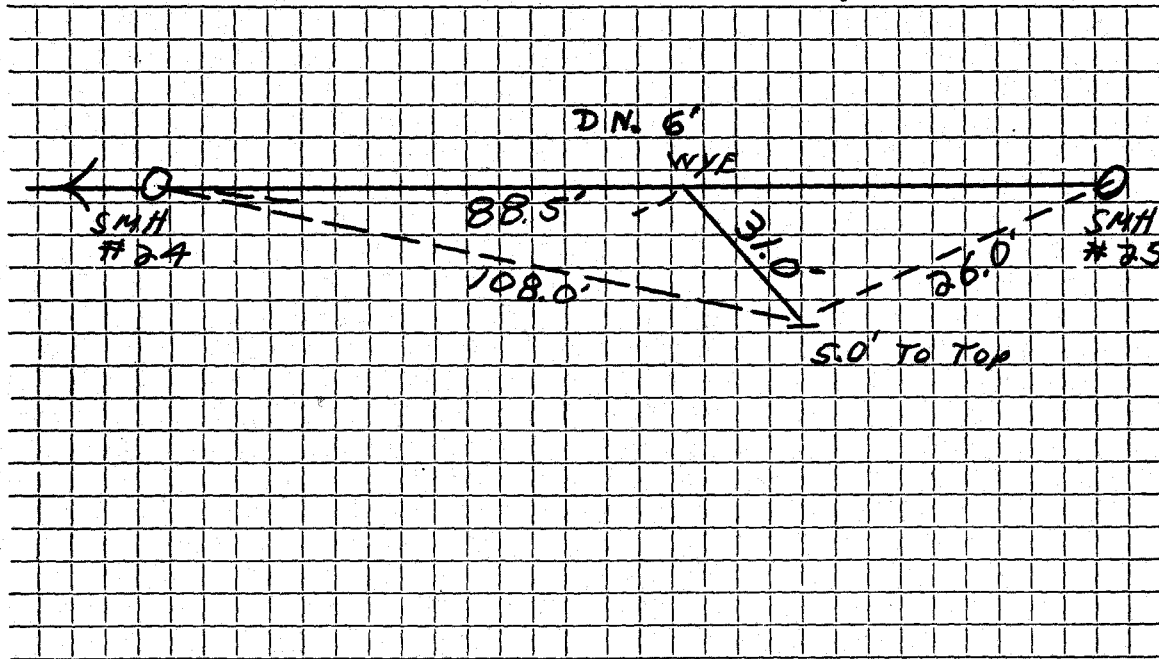

Connection made in Summer..... Street. Work completed

Remarks:
.....
.....