

DATE _____


TOWN OF LEXINGTON — BOARD OF PUBLIC WORKS

SEWER DIVISION

Sketch of Service Here

GARAGE

38

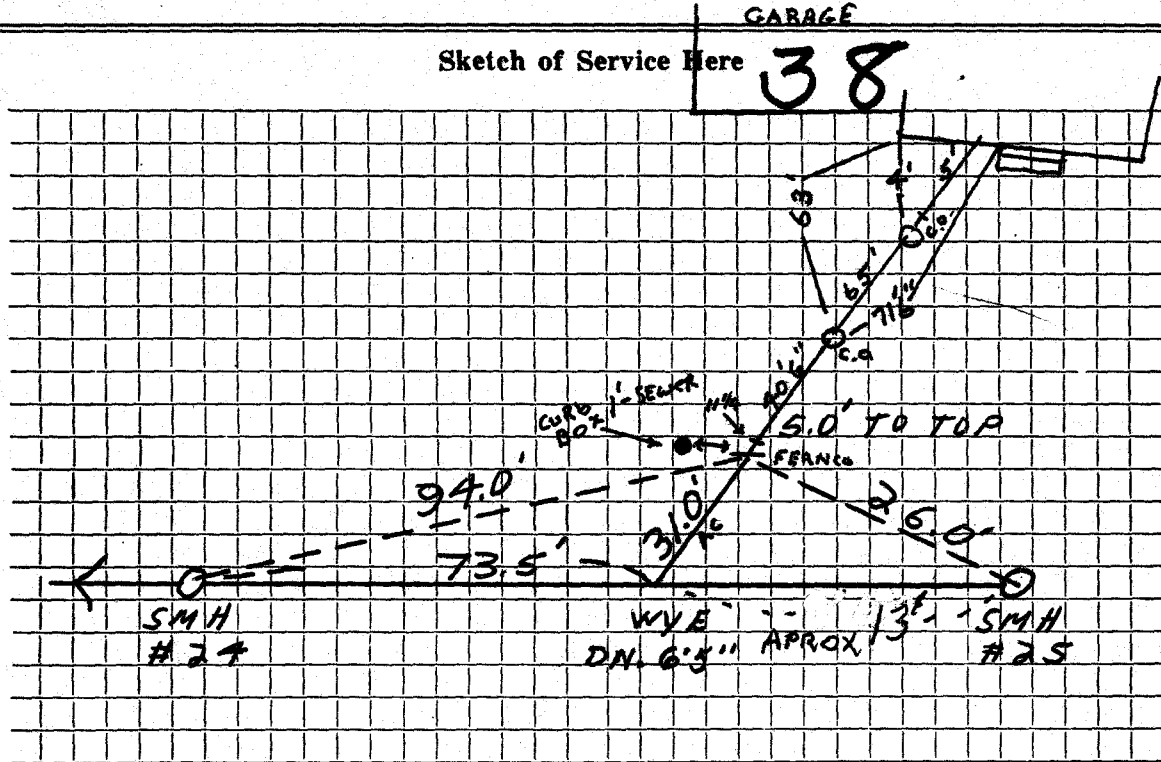

Connection made in Summer S.T. Street. Work completed

Remarks: