

77

Name **Gerald P. Johnson**

Service No. **19**

Address **#6 Summer Street**

JUN 20 1977

6 Summer Street

Location

Kind of Pipe **A.C.**

Size **6"**

Size of Main **8"**

~~REPAIR~~ **New Service Ferrari #3279**

Location


Date	Material	Amount	Total	Date	Amount
10-4-74	10.0 A.C.	\$7.00	\$70.00	5/2/77	Deposit 70.00
6/2/77	35' 6" transite pipe				
	10' 4" cast iron				

DATE _____

TOWN OF LEXINGTON — BOARD OF PUBLIC WORKS

SEWER DIVISION

Sketch of Service Here **6**

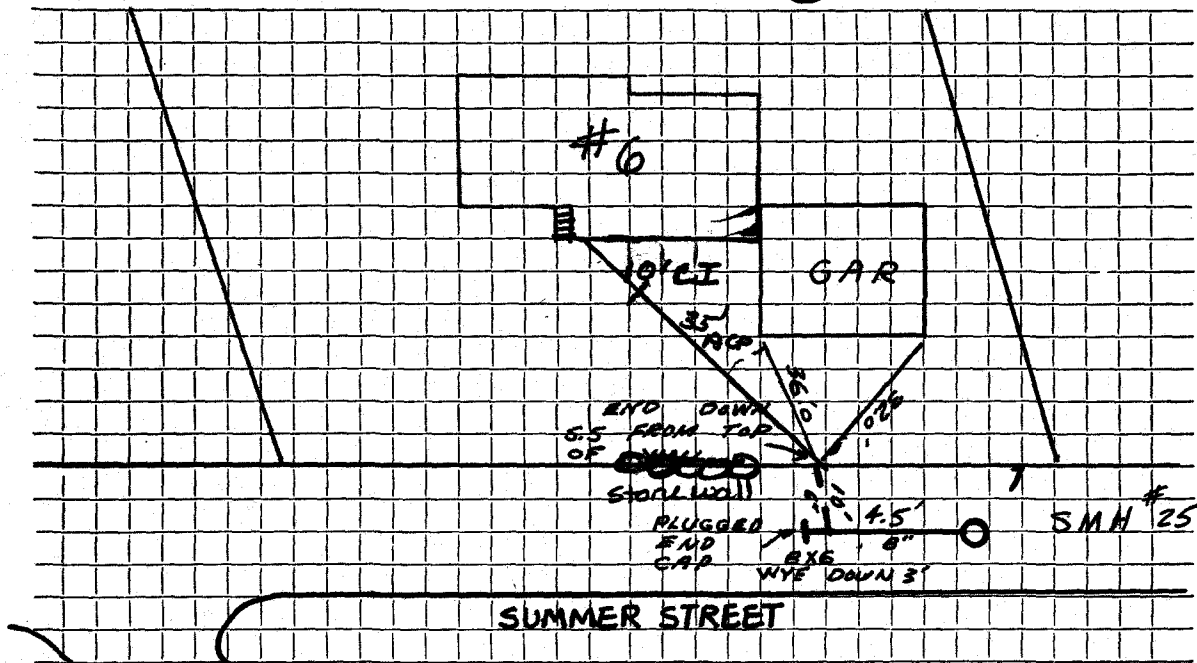

Connection made in Street. Work completed

Remarks:
.....
.....