


DATE 2-1-95

TOWN OF LEXINGTON — BOARD OF PUBLIC WORKS
SEWER DIVISION

Sketch of Service Here **7**

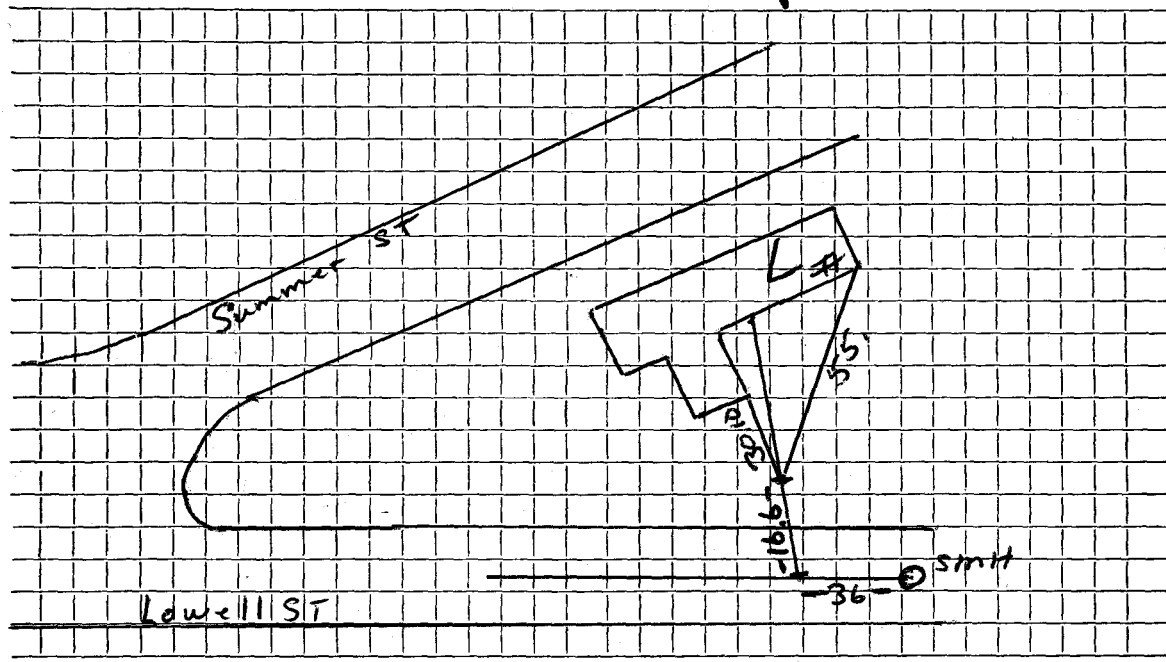

Connection made in Street. Work completed ... 1-23-95

Remarks: 4.6 - deep @ Connection in Street

Two Electric Duct lines and 1, 8" drain in ST.

In driveway behind house