

Name Keith Chase

Service No. 15

Address 9 Summer Street

9 Summer Street

Location

Kind of Pipe

Size 6"

Size of Main 8"

~~Repair or Renewal~~ - New Service W. O. # 7630 Sibley #1562

Location NOV 23 1970


Date	Material	Amount	Total	Date	Amount
5/6/70	Labor	162 57		4-25-70	150 00
5/7/70	"	55 74	218 31	3-15-71	81 79
	10% O.H.		21 83	12-23-71	103 08
	30' 6" Transite pipe .90		27 00		<del>284</del> <del>17</del>
	1 90° Elbow		5 65		253 08
	1 1" Nipple		1 21		
	1 8x6 Saddle		11 06		
	1 6" Plug		1 93		
	1 Bag cement		1 80		
	1/2 Ton hot top 6.00		3 00		
	1 Ld. gravel		14 00		
	6 Ton Stone @ 1.65		9 90		
	2 Dozen brisk .07 each		1 68		
	3 Hrs. Trucking 3.00		9 00		
	1 Hr. Shovel		6 50		
	2 Hrs. Pump 1.00		2 00		
			334 87		
			81 79		
			253 08		
6/18/70	78' 6" Transite pipe				Bill sent 103.08
	15' 4" Cast Iron pipe				

DATE \_\_\_\_\_

# TOWN OF LEXINGTON — BOARD OF PUBLIC WORKS

## SEWER DIVISION

Sketch of Service Here **9**

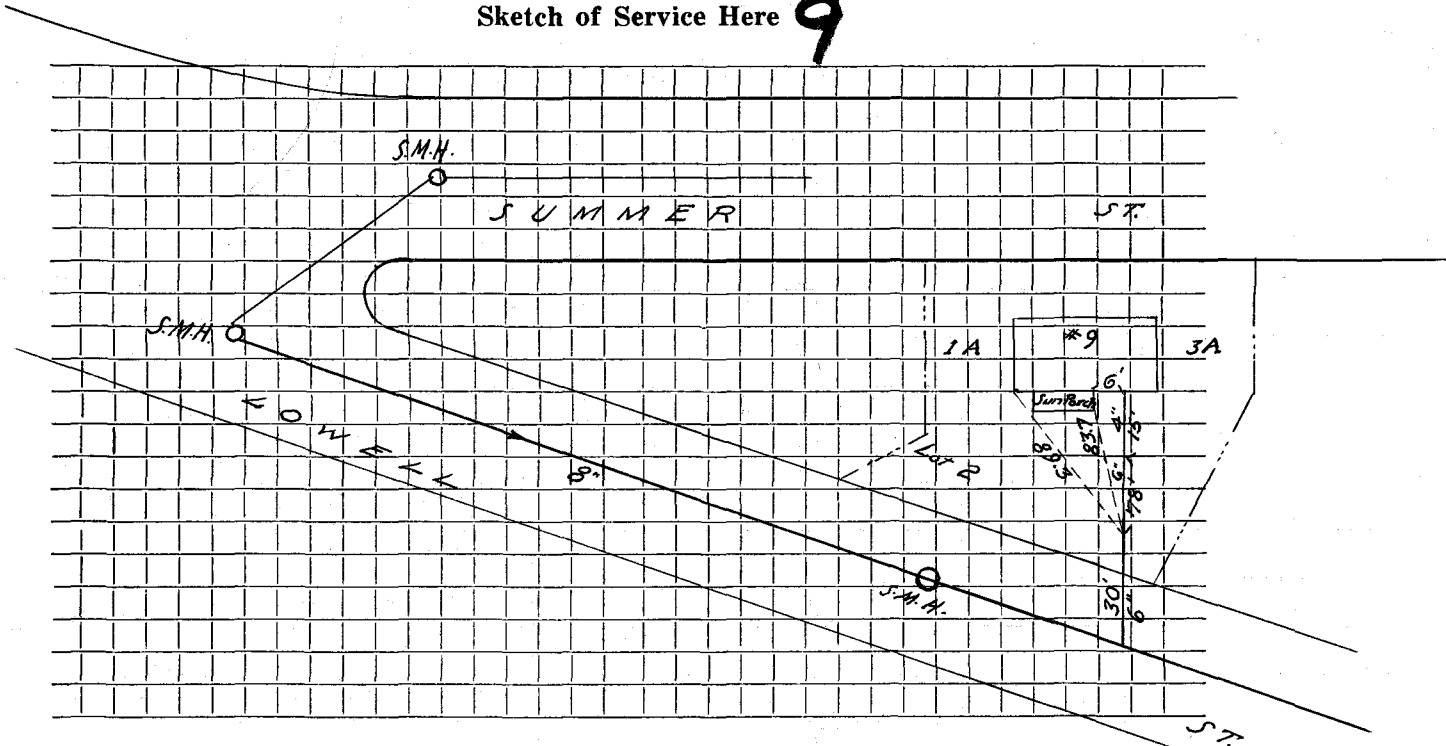

Connection made in ..... Street. Work completed .....

Remarks: .....  
.....  
.....