

Name Carroll Taylor

Service No. 581052

Address ~~DOX FILLER ROAD~~ ² Summit RoadLexington, Mass. ² Summit Rd. Location ~~DOX FILLER ROAD~~ ² Summit Road

Kind of Pipe

Size 6"

Size of Main 8"

~~Repair - Renewal~~ - New Service

Location

Date	Material	Amount	Total	Date	Amount
Dec. 3, '46					
Dec. 9, '46	Labor	518 14	518 14	Nov 30 '46	425 00
	10% Overhead		51 81	Jan 15 '47	439 25
	180' - 6" Sewer Pipe @.256		46 08	Compressor 18 hrs. @2.75	914 25
	1 - 6" Elbow		70	Trucking 2 hrs. @3.00	6 00
	1 - 6" Bend		67	Trucking 22 hrs. @.75	16 50
	Cement 5 bags		4 00		
	500 Brick		8 35		
	13.75 Tons Gravel		6 50		
	3.75				
	4 tons of Rice Stone		8 00		
	Patching 9 x 7		21 00		
	Labor Bell Shovel 18 hrs. @9.00		162 00		
	Moving Shovel		15 00		

TOWN OF LEXINGTON—DEPT. OF PUBLIC WORKS

SEWER DIVISION

DATE


NO.

The undersigned applies for the construction of a particular sewer connecting No. Street and hereby agrees to comply with the Rules and Regulations governing the construction and use of Particular Sewers, as now or at any future time established by the Board of Selectmen.

Am't of estimate \$.....

Am't Paid \$.....

..... Owner

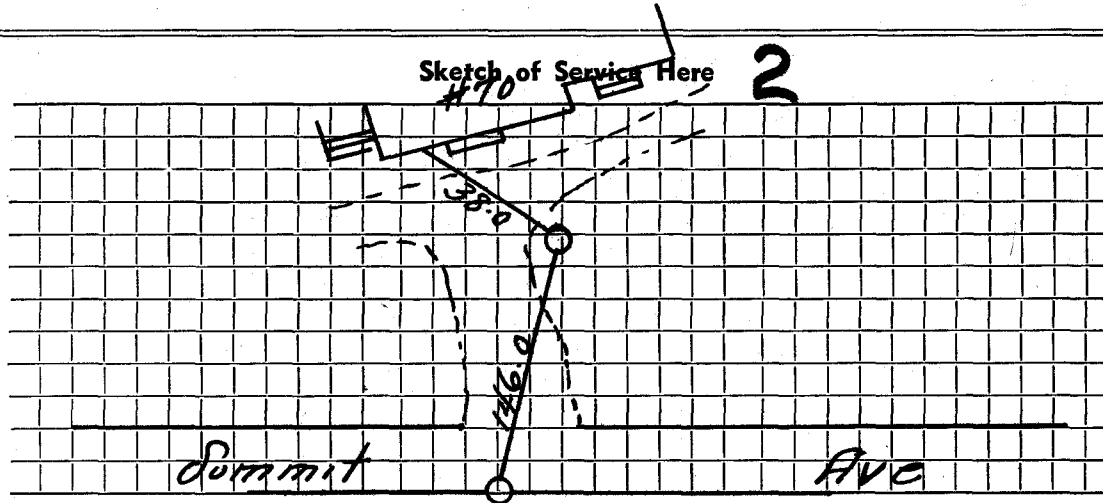

Connection made in Street.

Work completed 19..

Remarks: