

Name Grace Johnson

Service No. 24 1038

Address 22 Summit Avenue

Lexington, Mass. 22 Summit Rd. Location 22 Summit Avenue

Kind of Pipe

Size 6"

Size of Main 8"

~~Repair - Renewal~~ - New Service

Location

Date	Material	Amount	Total	Date	Amount
Nov. 21, '46					
26, '46	Labor	263 10	263 10	Sept 25 '46	200 00
	10% Overhead		26 31	Dec 31 '46	310 63
	133' - 6" Sewer Pipe @.24		31 92		389 37
	1 - 6 x 6 Tee		2 00		
	1 - 6" Elbow		70		
	Joint Compound		8 04		
	1 - Bag Of Cement		80		
	Patching 9 x 3		9 00		
	Compressor 8 hrs. @1.75		14 00		
	Compressor 10 hrs. @2.75		27 50		
	Labor Trucking 8 hrs. @.75		6 00		
			389 37		

TOWN OF LEXINGTON—DEPT. OF PUBLIC WORKS

SEWER DIVISION

DATE


NO.

The undersigned applies for the construction of a particular sewer connecting No. Street and hereby agrees to comply with the Rules and Regulations governing the construction and use of Particular Sewers, as now or at any future time established by the Board of Selectmen.

Am't of estimate \$.....

Am't Paid \$.....

..... Owner

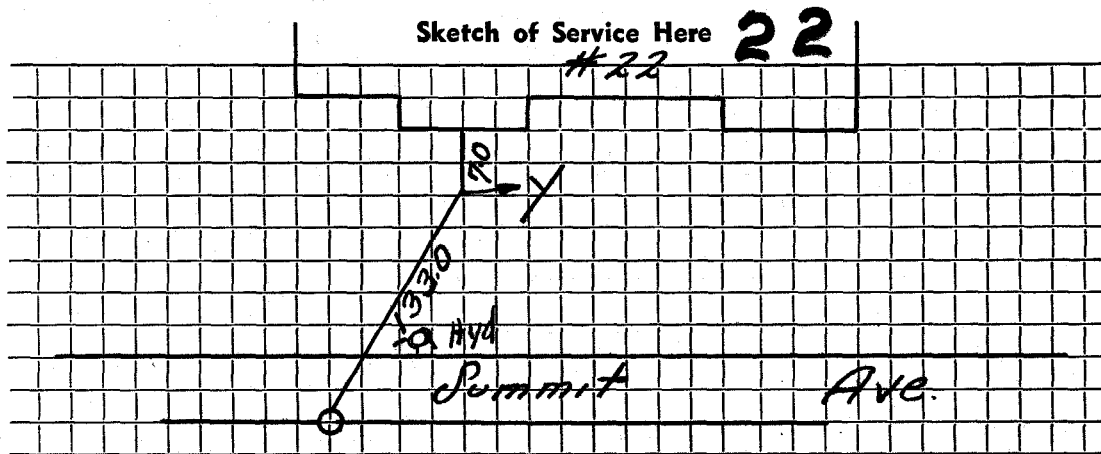


Connection made in Street.

Work completed 19..

Remarks:

DATE _____

TOWN OF LEXINGTON — BOARD OF PUBLIC WORKS
SEWER DIVISION

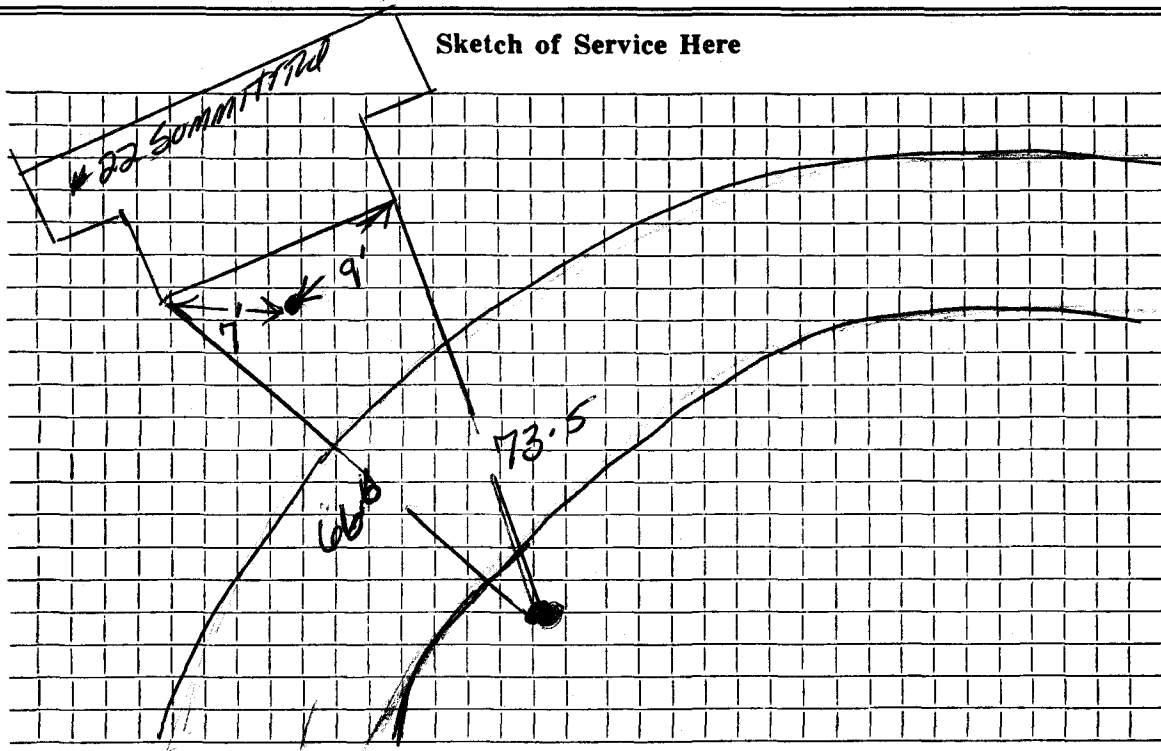

Connection made in Street. Work completed

Remarks:

.....

.....