

Name Winthrop Potter

Service No. 5

Address 25 Summit Road

25 Summit Road

Location

Kind of Pipe

Size 6"

Size of Main 8"

~~Repair - Renewal - New Service~~ RENEWAL W.O. # 6294

Location AUG 5 1968

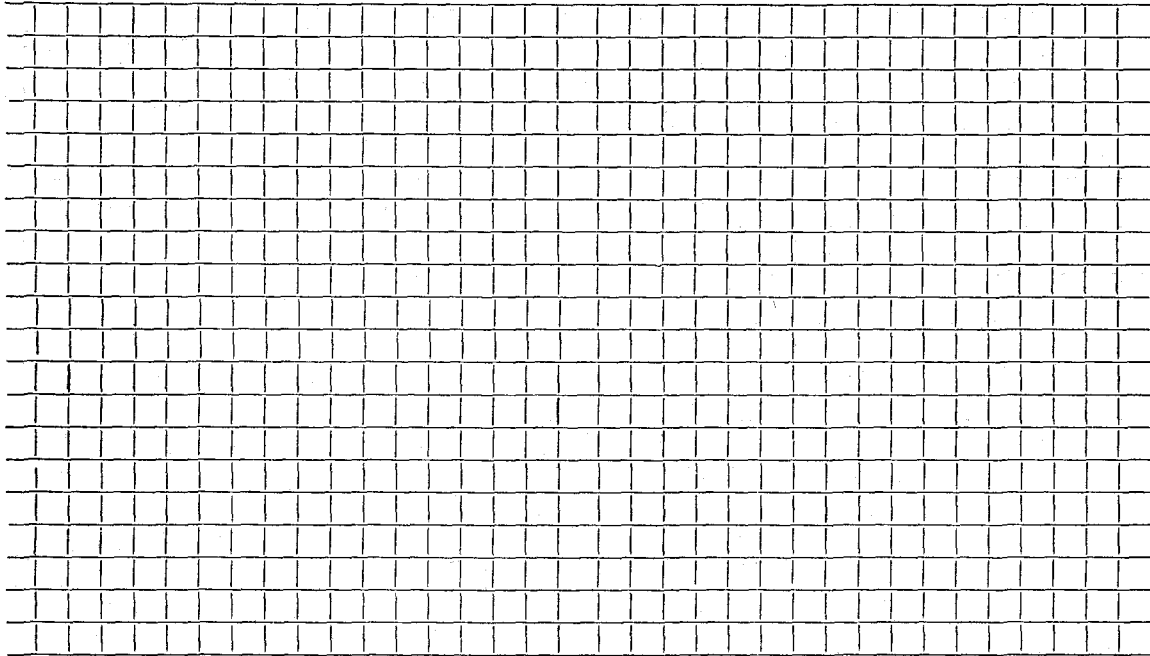
Date	Material	Amount	Total	Date	Amount
4/3/68	Labor	102 78		3-11-68	500 00
4/4/68	Labor	38 35		8-5-68	191 39
4/4/68	Labor /	15 58			308 61
	10% O.H.	15 67	172 38		
	60" Transite @ .88		52 80		
	1 bag cement		1 55		
	2 Dozen brick		1 08		
	1 ton hot top		5 80		
	5 yds. load @ 3.50		21 00		
	10 lbs. grass seed @ 1.10		11 00		
	4½ hrs. trucking @ 3.00		13 50		
	3 hrs. shovel @ 6.50		19 50		
	1 hr. loader		4 00		
	½ hr. roller @ 3.00		1 50		
	trailer		2 00		
	½ hr. compressor @ 5.00		2 50		
	TOTAL COST		308 61		

DATE \_\_\_\_\_

TOWN OF LEXINGTON — BOARD OF PUBLIC WORKS

**SEWER DIVISION**

Sketch of Service Here

A large rectangular grid of graph paper, consisting of 20 columns and 20 rows of small squares, intended for sketching sewer service details.

Connection made in ..... Street.                      Work completed .....

Remarks: .....  
.....  
.....