

Name John J. Monahan

Service No. 33

Address #34 SUMMIT RD (Two SERVICES)

34 Summit Road

Location

Kind of Pipe ACP.

Size 6"

Size of Main 8"

Repair ~~Removal~~ New Service Valeri #4088


Location MAR 14 1983

Date	Material	Amount	Total	Date	Amount
12-15	78 20'x6" ACP @	\$19.00	= \$380.00	10-18-82	Deposit 380.00
12-19	78 17'x6" ACP @	\$19.00	= \$323.00		
10/29/82	97' x 6" PVC Pipe				
	4 22½° x 6" Elbows				
	1 45° x 6" Elbow				
	1 6" Wye				
	2 6" x 4" Donuts				
	2 20" C.I. Manhole Covers				
	700 Red Sewer Brick				

DATE 12-19-78

TOWN OF LEXINGTON — BOARD OF PUBLIC WORKS
SEWER DIVISION

Sketch of Service Here **34**

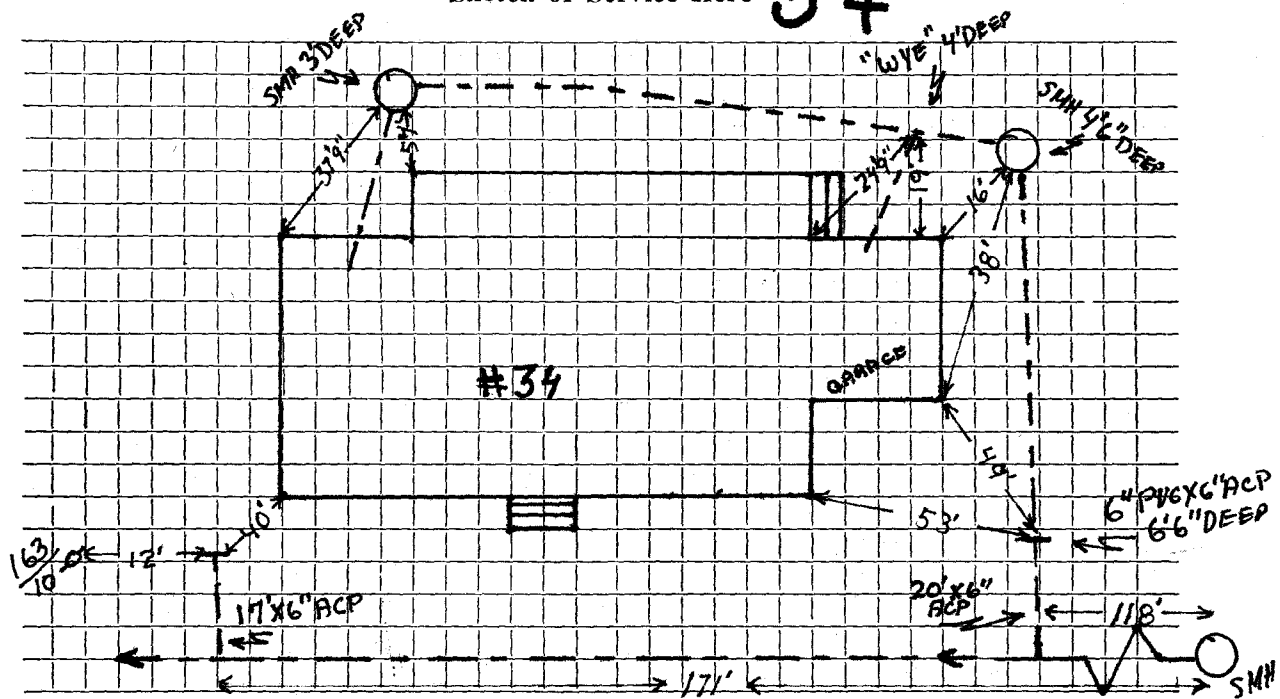

Connection made in SUMMIT RD Street. Work completed 10-29-82

Remarks: TWO SERVICES BROUGHT OFF THE ROAD FOR THIS HOUSE - SERVICE ON LEFT NOT IN USE