

Name

Service No.

Address #38 Summit Rd

38 Summit Rd.

Location

Kind of Pipe A.C.

Size 6"

Size of Main 8"

Repair—Renewal—New Service


Location

Date		Material	Amount	Total	Date	Amount	
12-20-	78	15' 6" A.C.P. @	\$ 19. 00-	\$285 00			

DATE _____

TOWN OF LEXINGTON — BOARD OF PUBLIC WORKS
SEWER DIVISION

Sketch of Service Here **38**

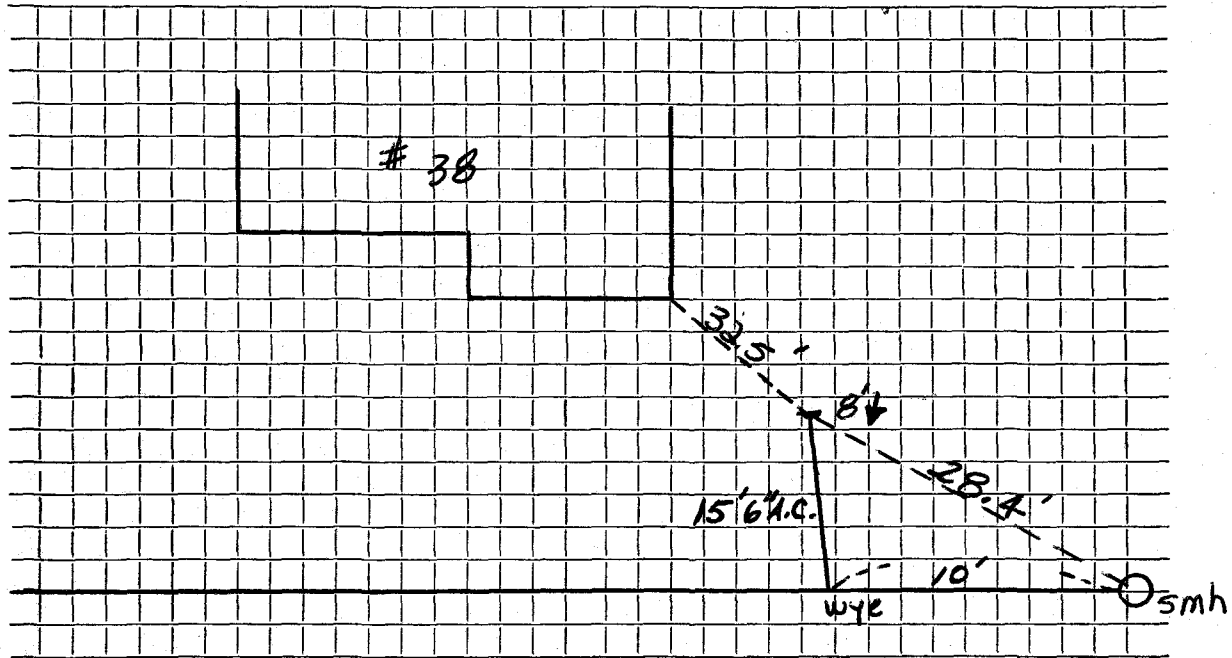

Connection made in Street. Work completed

Remarks:

.....
.....