

Name H. Heil Connolly

Service No.

Address #4 Summit Road

4 Summit Road

Location

Kind of Pipe

Size 6"

Size of Main 8"

Repair—Renewal—New Service

Permit No. 0854 Span To Cell

Location

Date

Material

Amount

Total

Date

Amount

~~8/13~~


8/22

96

4" P.V.C.

6" P.V.C.


4"X6" FERNCO

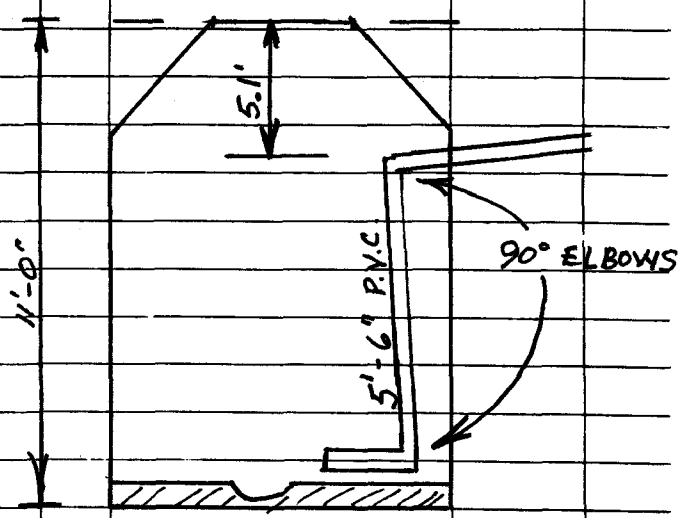

DATE 15 August 1996

TOWN OF LEXINGTON — BOARD OF PUBLIC WORKS
SEWER DIVISION

Sketch of Service Here **4**

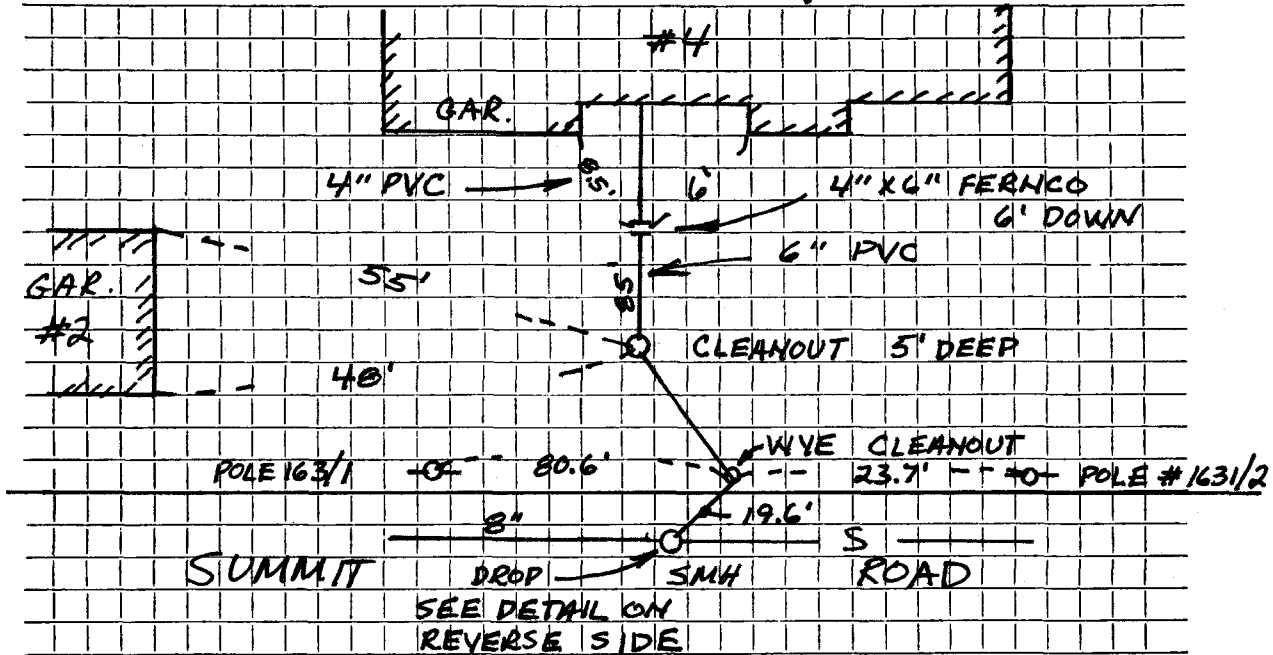

Connection made in SUMMIT ROAD Street. Work completed Tocci Excavation

Remarks:

.....

.....

BOOK 06-U