




DATE \_\_\_\_\_

TOWN OF LEXINGTON — BOARD OF PUBLIC WORKS

SEWER DIVISION

Sketch of Service Here **41**

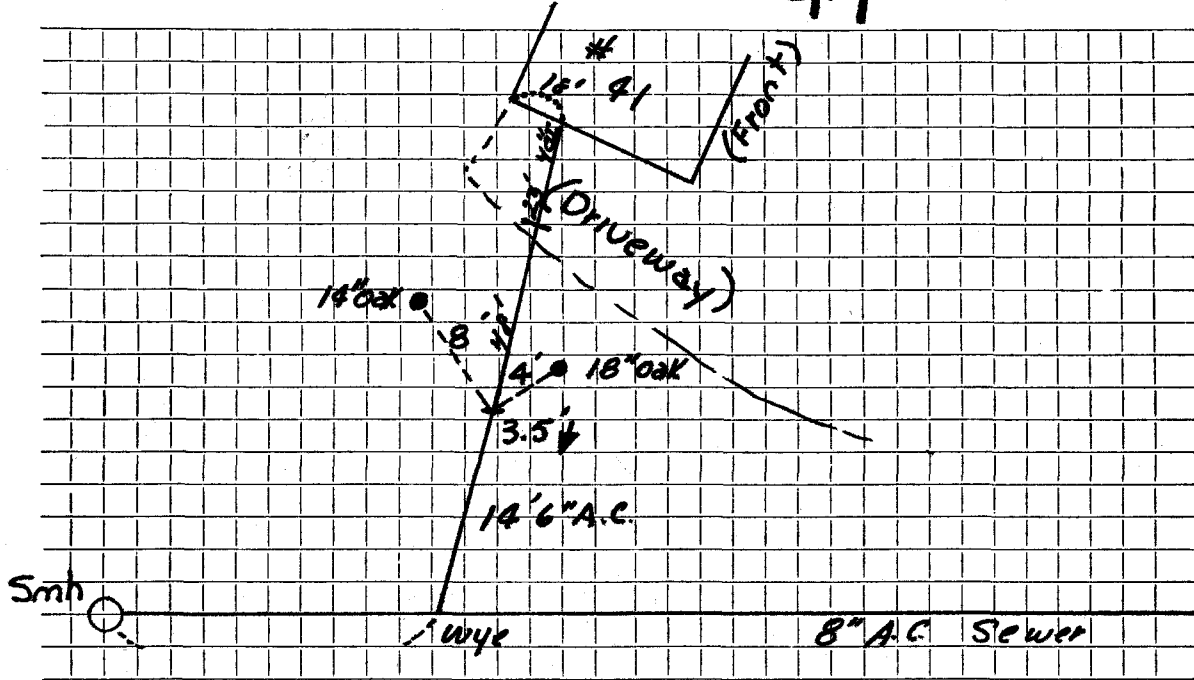

Connection made in ..... Street. Work completed .....

Remarks: .....  
.....  
.....