

Name

Service No.

Address } Vacant Lot #48 } Summit Rd.

Location

Kind of Pipe A.C.

Size

6"

Size of Main

8"

Repair—Renewal—New Service

Location


Date	Material	Amount	Total	Date	Amount
12-12-78	33' 6" A.C.P. @	\$19.00	\$627.00		

DATE _____

TOWN OF LEXINGTON — BOARD OF PUBLIC WORKS

SEWER DIVISION

Sketch of Service Here

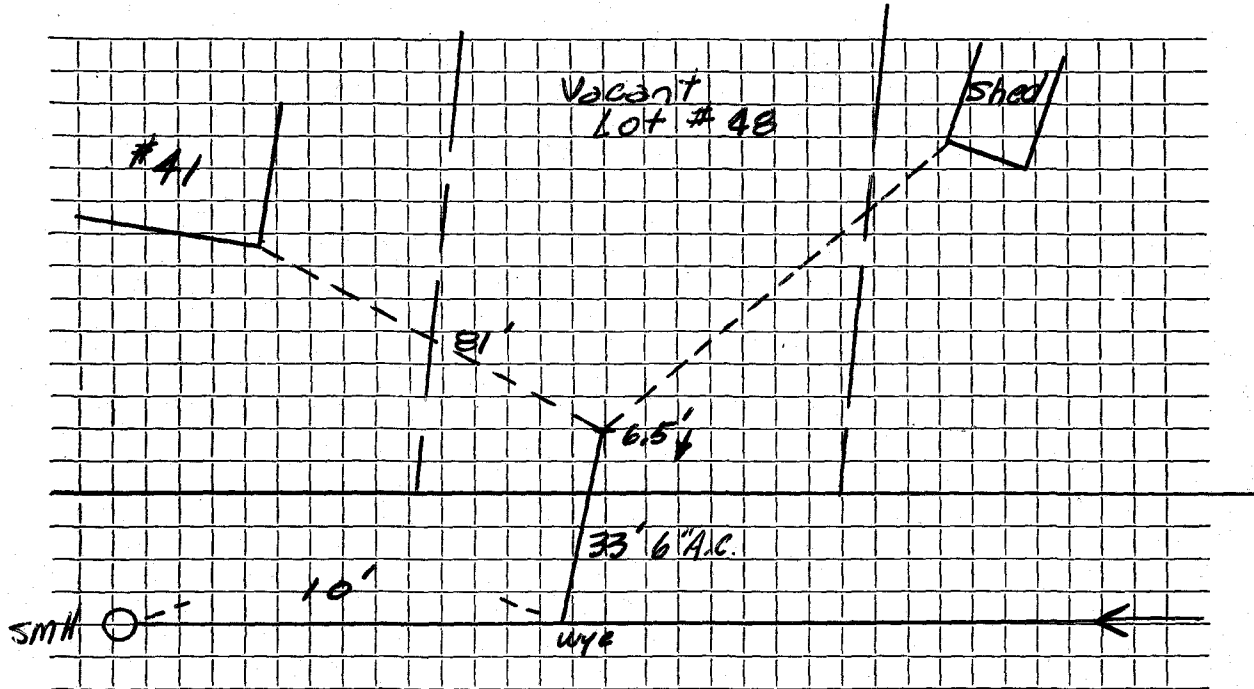

Connection made in Street. Work completed

Remarks:


.....
.....

DATE _____

TOWN OF LEXINGTON — BOARD OF PUBLIC WORKS

SEWER DIVISION

Sketch of Service Here **48**

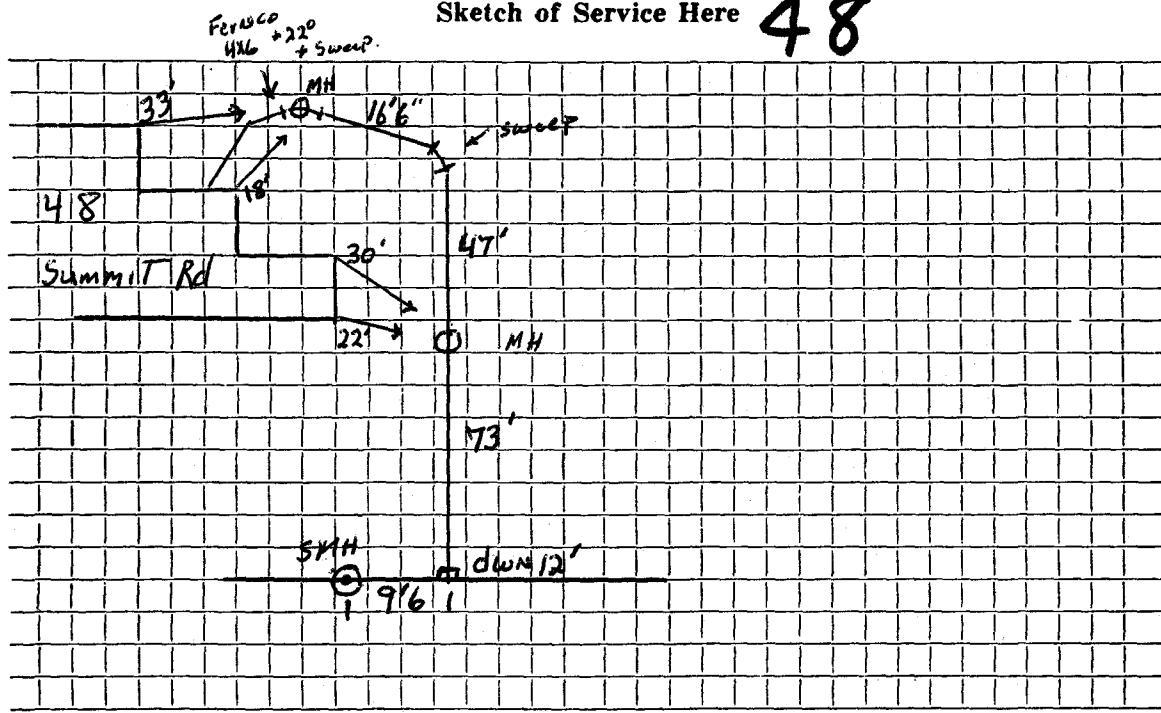

Connection made in Street. Work completed

Remarks: WATER beside MH. Original Service (5-6-59 289'-6" Transite, 1-6" clay E.lbow.)