

Name Henry L. Meadows

Service No. 63

Address 5 Summit Road

5 Summit Road

Location

Kind of Pipe

Size 6"

Size of Main 8"

~~Repair~~—Renewal—~~New Service~~ W.O. #3445.

Location *Comm 7-28-75*


Date	Material	Amount	Total	Date	Amount
6-17-75	Labor \$23.78			<i>6-30-75</i>	<i>Deposit 154.40</i>
6-18-75	" <u>71.36</u>	\$ 95.14			
	10% O.H.	<u>9.51</u>	\$104.65		
1	1 1/2° Elbow		3.94		OUTSIDE (NON-CHARGE)
1	6" NIP		1.76	6-17-75	Labor 166.48
1	1 1/2° Sweep		6.95	6-18-75	" <u>70.63</u> \$237.11
1	O Ring		3.05	10'	6" Transite Pipe @1.27 12.70
3 1/2	Yds. Loam @5.00		16.50	1	5' x 6" Nipple @1.40 7.00
5	Lbs. Seed @.35		1.75	1	1' x 6" Nipple 2.51
1	Hr. Trucking		3.00	1	6" x 6" Nipple 1.76
2	Hrs. Backhoe @6.50		13.00	1	90° Elbow 5.63
			<u>\$ 154.60</u>	2	Yds. Loam @5.00 10.00
				2	Lbs. Grass Seed @.35 .70
				1	6' x 11' Patch 42.00
				1 1/2	Hrs. Trucking @3.00 4.50
				2	Hrs. Pick up @1.50 3.00
				4 1/2	Hrs. Backhoe @6.50 29.25
				1	Hr. Compressor <u>5.00</u>
					\$389.10

DATE \_\_\_\_\_

TOWN OF LEXINGTON — BOARD OF PUBLIC WORKS

SEWER DIVISION

Sketch of Service Here **5**

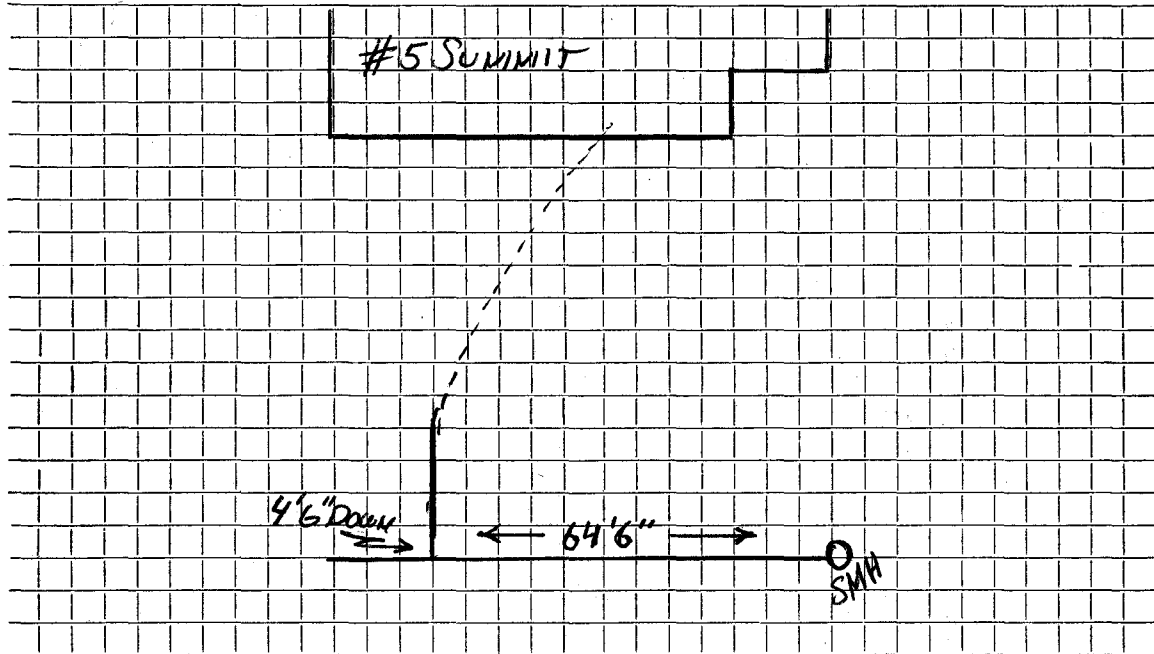

Connection made in ..... Street. Work completed .....

Remarks: .....

.....  
.....