

Name *William A. Gann Co.*

Service No. *25 930*

Address *Lot 9, Summit Road*

9 Summit Road

Location *9 Summit Rd*

Kind of Pipe

Size *6"*

Size of Main *8"*

~~Replaces Main~~ **New Service**

Location

Date	Material	Amount	Total	Date		Amount
<i>Oct. 1931</i> <i>012-28-31</i> <i>for</i> <i>40.00</i>	SEWER CONNECTION AT ESTIMATED COST	<u>\$40 00</u>		<i>Jan. 27 1932</i>	<i>Cash</i>	<i>40 -</i>
	Labor					

Hadley Press, Inc., Lexington

TOWN OF LEXINGTON—BOARD OF PUBLIC WORKS

SEWER DIVISION

DATE 10-13-31

NO. _____


The undersigned applies for the construction of a particular sewer connecting No. _____ Street and hereby agrees to comply with the Rules and Regulations governing the construction and use of Particular Sewers, as now or at any future time established by the Board of Selectmen.

Am't. of Estimate \$ 40.00

Am't. Paid \$ _____

Mrs. G. Burns Owner

Sketch of Service Here **9**

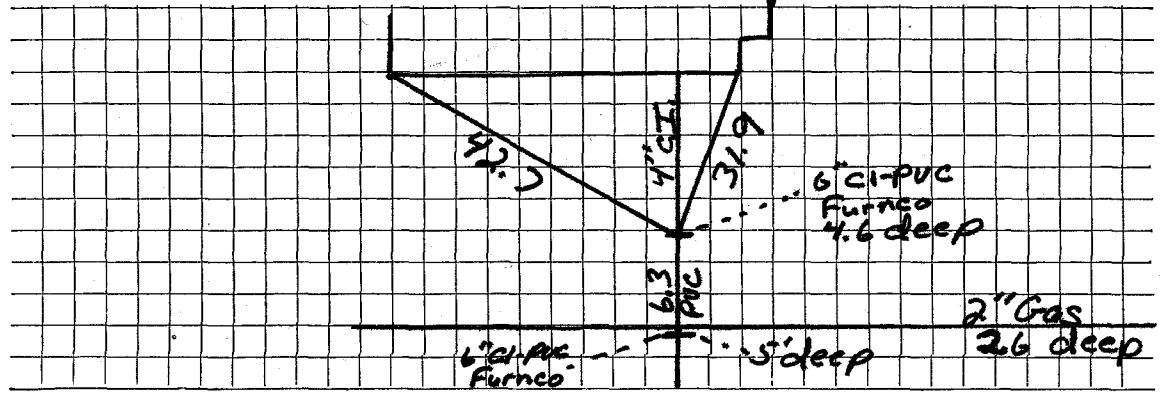

Connection made in _____ Street.

Work completed _____ 19

Remarks:

C.I. To property line
6" PVC out beyond Gas