

Name **Clarence H. Conroy**

Service No. **1 928**

Address **11 Cypress Rd., Arlington**

Cor. Summit & Follen Rds. Location Cor. Summit & Follen Rds. (3 Summit Rd)

Kind of Pipe

Size **6"**

Size of Main **8"**

~~Repair~~ **New Service**

Location

Date		Material	Amount	Total	Date	Amount
1936						
Jan. 15	260	hrs. labor @ 55¢	143 00		<i>Jan 9. 1936 Deposited</i>	96 00
<i>rem. 5-12-26</i>	30	" " @ 60¢	18 00			
<i>to Russell</i>	36'	6" Sewer Pipe @ 17¢	6 12			
		Joint Comp.	73			
		Trucking	<u>1 50</u>			
				\$169 35		
		Say: \$96. 00				
		Main 11 ft. deep.				
		Ground frozen.				
		Labor				

Hadley Bros, Inc., Lexington

TOWN OF LEXINGTON—BOARD OF PUBLIC WORKS

SEWER DIVISION

DATE December 30-1935

NO. _____


The undersigned applies for the construction of a particular sewer connecting No. Lot A, Summit & Folger Roads Street and hereby agrees to comply with the Rules and Regulations governing the construction and use of Particular Sewers, as now or at any future time established by the Board of Selectmen.

Am't. of Estimate \$ 96.00 ✓

Am't. Paid \$ _____

Blair H. Emery Owner

✓ Included trench repairs.

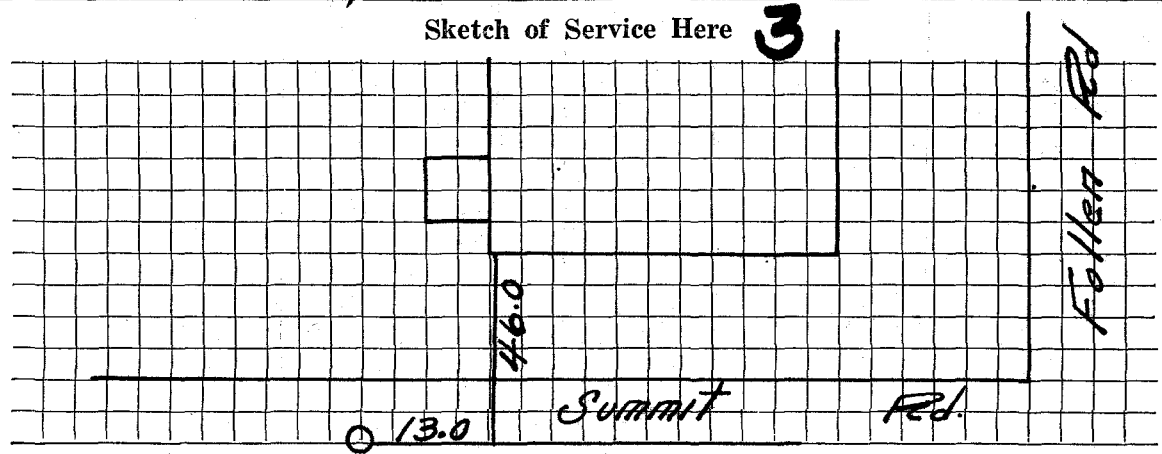

Connection made in _____ Street.

Work completed _____ 19

Remarks: