

Name **Abbie Fuller**

Service No. **96 1144**

Address **1 Sunnyknoll Avenue**

**1 Sunny Knoll Ave.**

Location **1 Sunnyknoll Avenue**

Kind of Pipe

Size **6"**

Size of Main **8"**

~~Repair~~ **Renewal** ~~New Service~~

Location

Date	Material	Amount	Total	Date	Amount
Nov. 11 '47	Labor	8 00		12/17/47	100 00
Dec. 19 '47	"	16 40		12/31/47	5 17
20	"	4 05	28 45		94 83
	10% Overhead		2 85	Dec. 19, '47 Labor	24 50
	104' - 6" Sewer Pipe		27 04	10' - 6" Sewer Pipe	2 60
	Joint Compound		6 24	Compressor 2 hrs. @ 1.75	3 50
	Compressor 2 hrs. @ 1.75		3 50	Joint Compound	60
	Hired Shovel 2 hrs. @ 7.00		14 00	Hired Shovel 2 hrs. @ 7.00	14 00
	Trucking 1 hr. @ .75		75	Trucking 1 hr. @ .75	75
	Patching 12 x 3		12 00	Patching 10 x 3	10 00
<b>5-16-69</b>	<b>Renewal</b>		<b>94 83</b>	<b>2-16-54</b>	<b>55 95</b>
<b>60'</b>	<b>6" Transite</b>			<b>28' 6" Sewer Pipe</b>	
<b>1</b>	<b>Adapter</b>				
				8-4-64	Roots 3/13/69
				8-17-64	Roots

**TOWN OF LEXINGTON—DEPT. OF PUBLIC WORKS**  
**SEWER DIVISION**

DATE .....


NO. ....

The undersigned applies for the construction of a particular sewer connecting No. ....  
 Street and hereby agrees to comply with the Rules and Regulations governing the construction and use of Particular  
 Sewers, as now or at any future time established by the Board of Selectmen.

Am't of estimate \$. ....

Am't Paid \$. ....

..... Owner

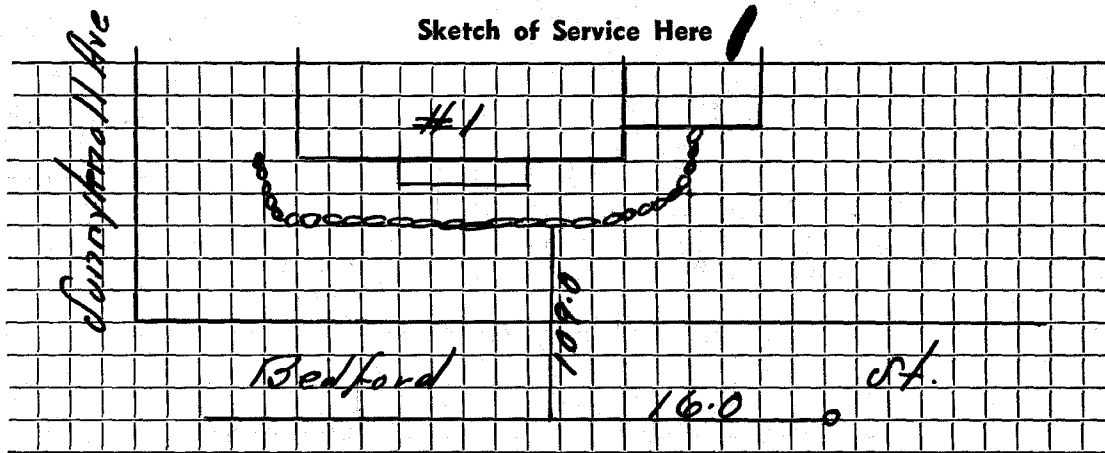

Connection made in ..... Street.

Work completed ..... 19..

Remarks: