




DATE 11-25-96

TOWN OF LEXINGTON — BOARD OF PUBLIC WORKS  
SEWER DIVISION

Sketch of Service Here **3**

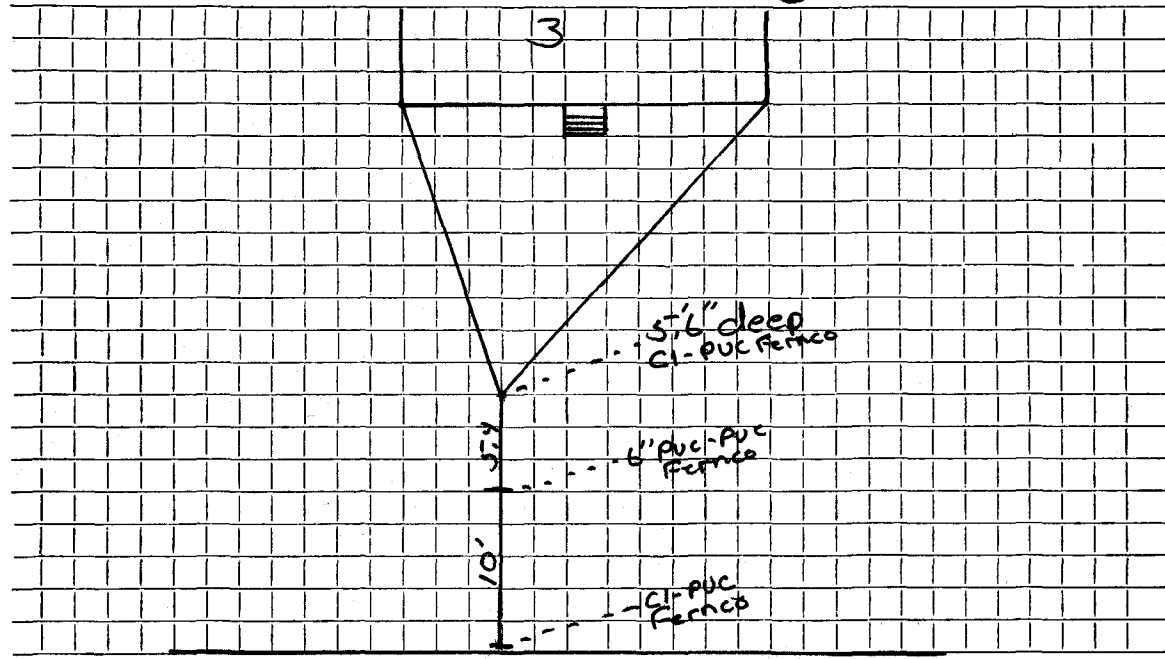

Connection made in ..... Street. Work completed 11-19-96.....

Remarks: Fence attached to nipple coming off 90° to Chimney.....

Same trench as water service.....